

RECEIVED

RECEIVED

JAN 13 2022

DEC 27 2021



From: Eldon Metz eldon@metzhome.us  
Subject: Scannable Document - sent from Scannable  
Date: December 22, 2021 at 10:25 AM  
To: Eldon Metz eldon@metzhome.us

OWRD

OWRD

Eldon


Eldon Metz, Cascade Buffalo Ranch

1" = 1320'

Tax Lot: 300



Township 8 South, Range 1 West, Section 8

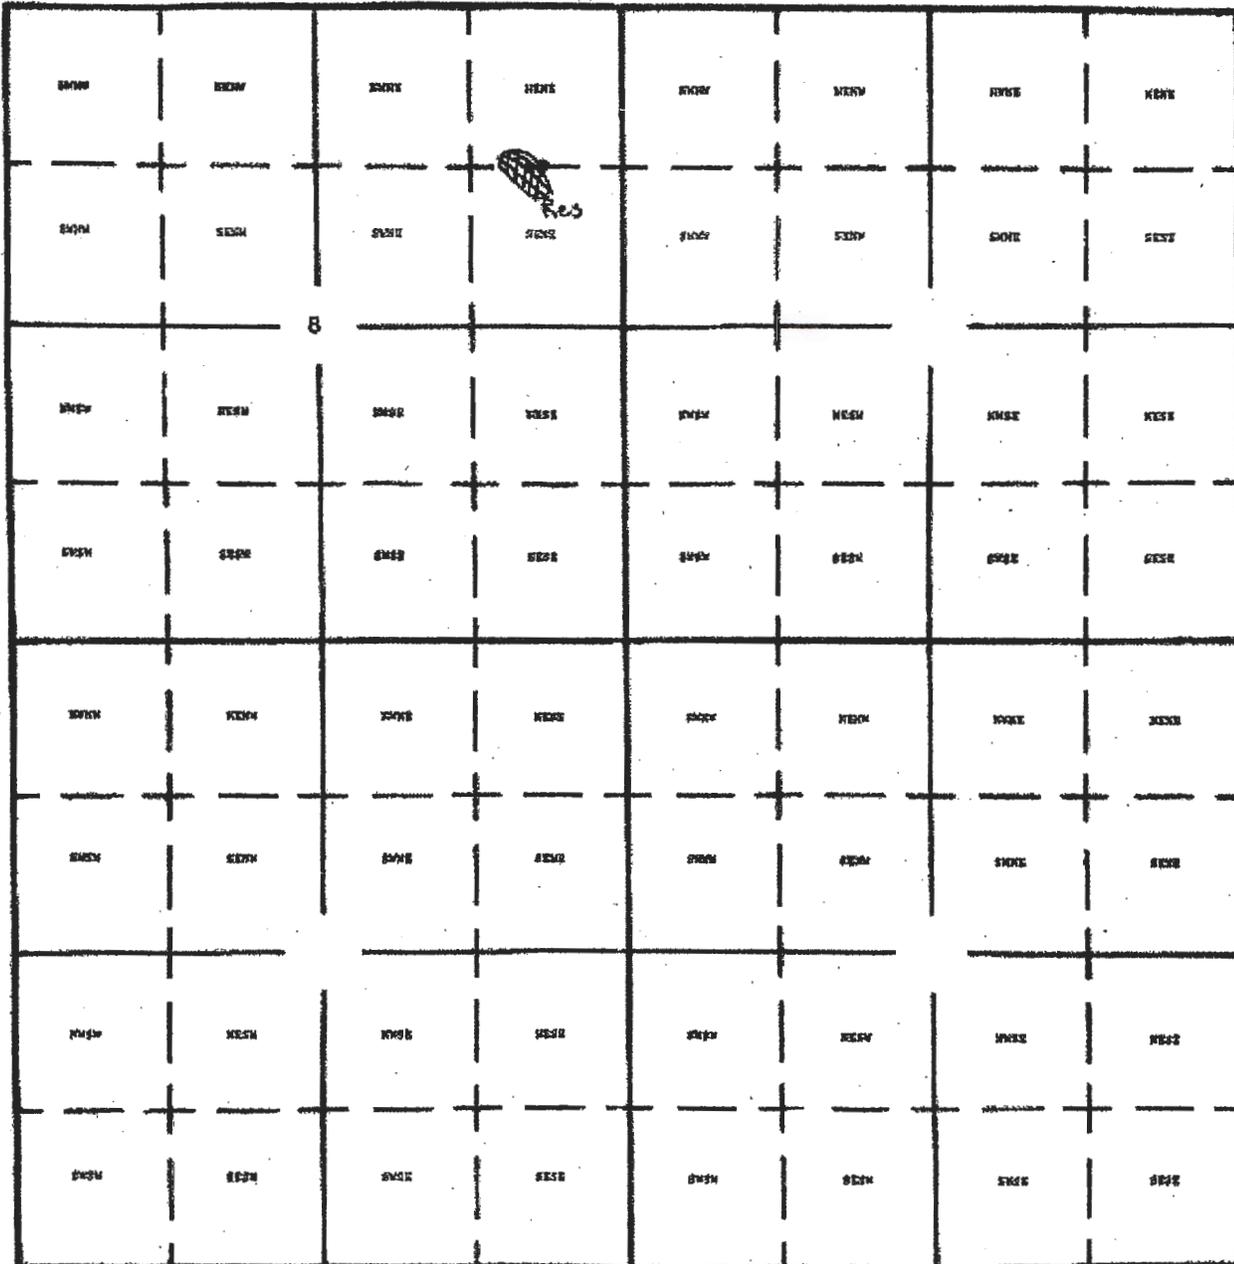

South

Center of Dam: 1320 Feet South and 700 Feet West from the NE Corner Section 8

RECEIVED BY OWRI