


RECEIVED

MAY 24 2021

OWRD

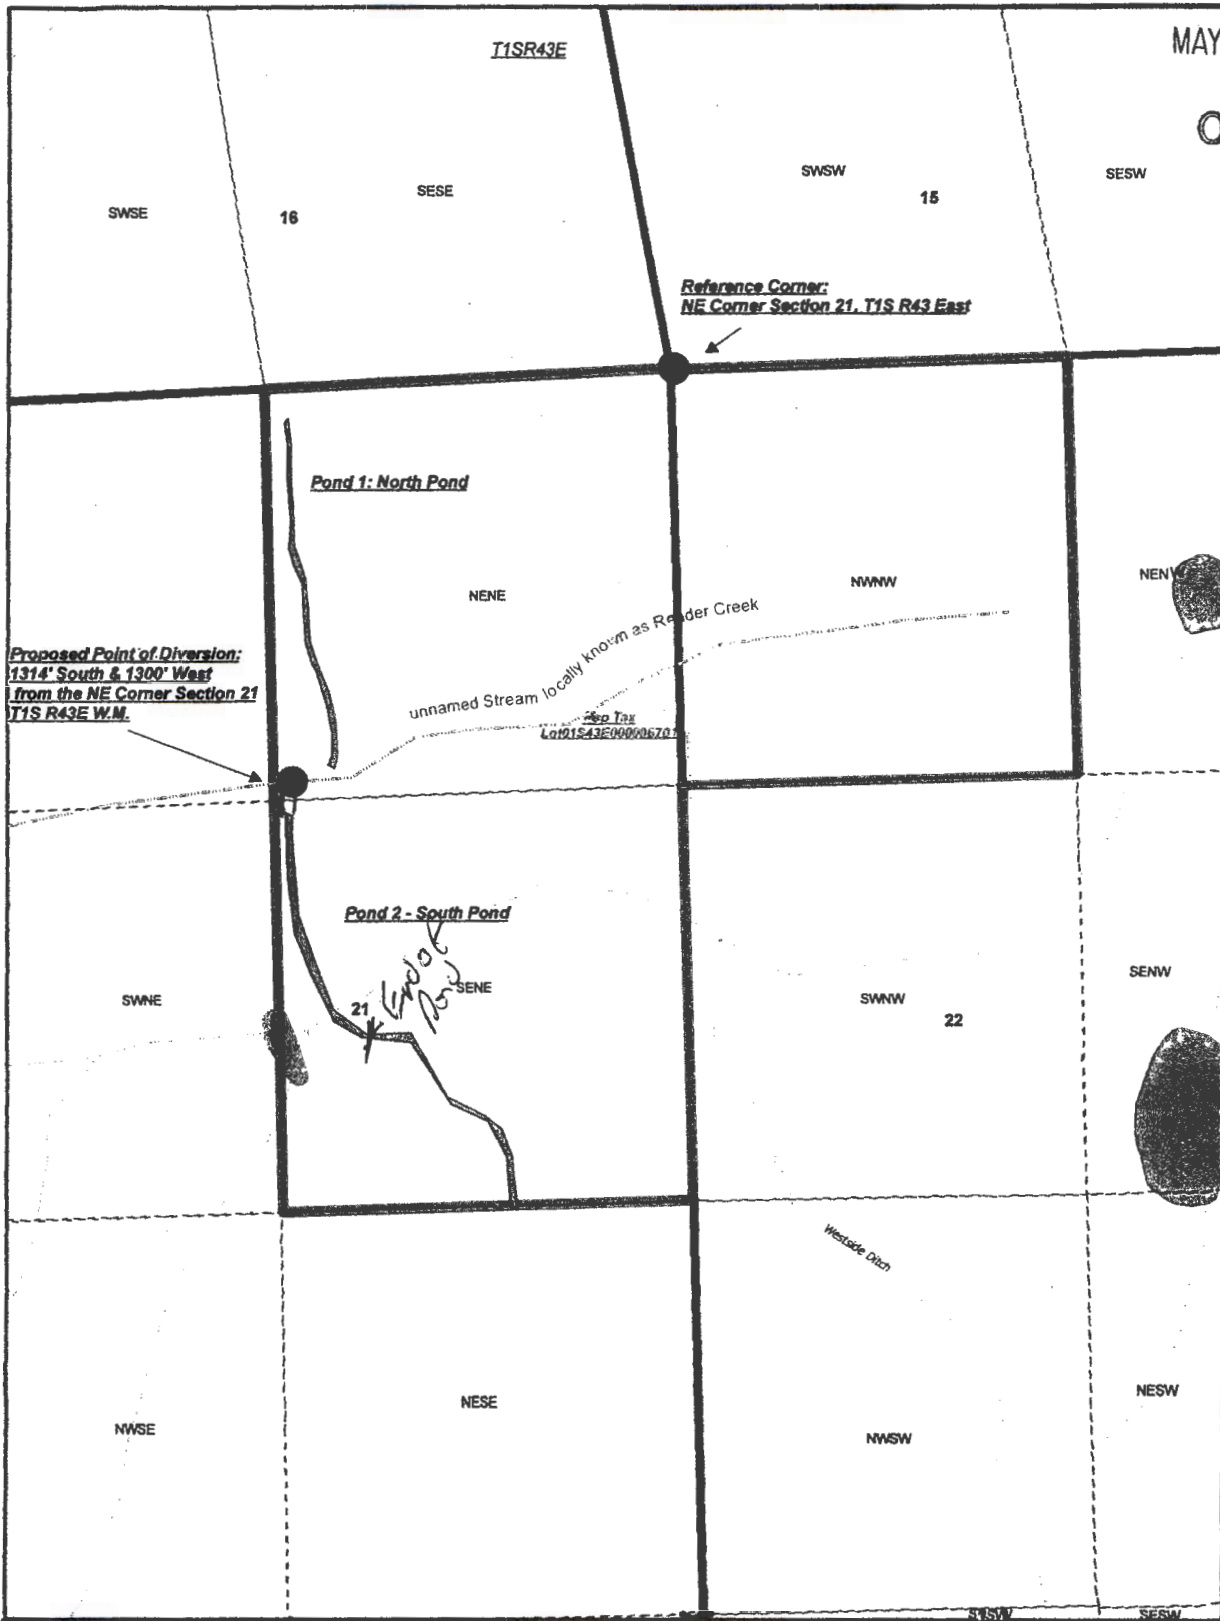

Longfellow Stored Water Application Map

Map Disclaimer:
 This product is for informational purposes and may not have been prepared for, or be suitable for, legal, engineering, or surveying purposes. Users of this information should verify or consult the primary data and information sources to ascertain the suitability of the information.
 This map is not intended to display property lines.

Disclaimer: This filing is the result of a manual search of the records of the Watermaster's Plat Cards and the WRS database. This filing has not been field checked. This is a right to be used as a guide only and is not intended to be used as a guarantee of accuracy. The plat card records are listed for the 40.0 acre section system within a section. If the water right listed within a quarter-quarter is not shown there are no 40.0 acre sections. We warrant that water rights for each lot - only a survey could accurately report how much of the water rights are groups are etc.

Legend

-  Longfellow_property
-  D7_TWP
-  D7_Sections
-  D7_QQ

1:4,800



RECEIVED

JUN 22 2018

OWRD