


**T34S R1W, WM,
JACKSON COUNTY, OR**

RECEIVED


DEC 29 2021

OWRD

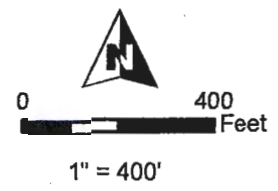

- POD
- Creek
- Stacey Reservoir Ap R-88671
- Section
- Tax Lot
- Quarter Quarter

POD (Stacey Reservoir) Location:
380' N, 1170' W of SE Cor Sec 20

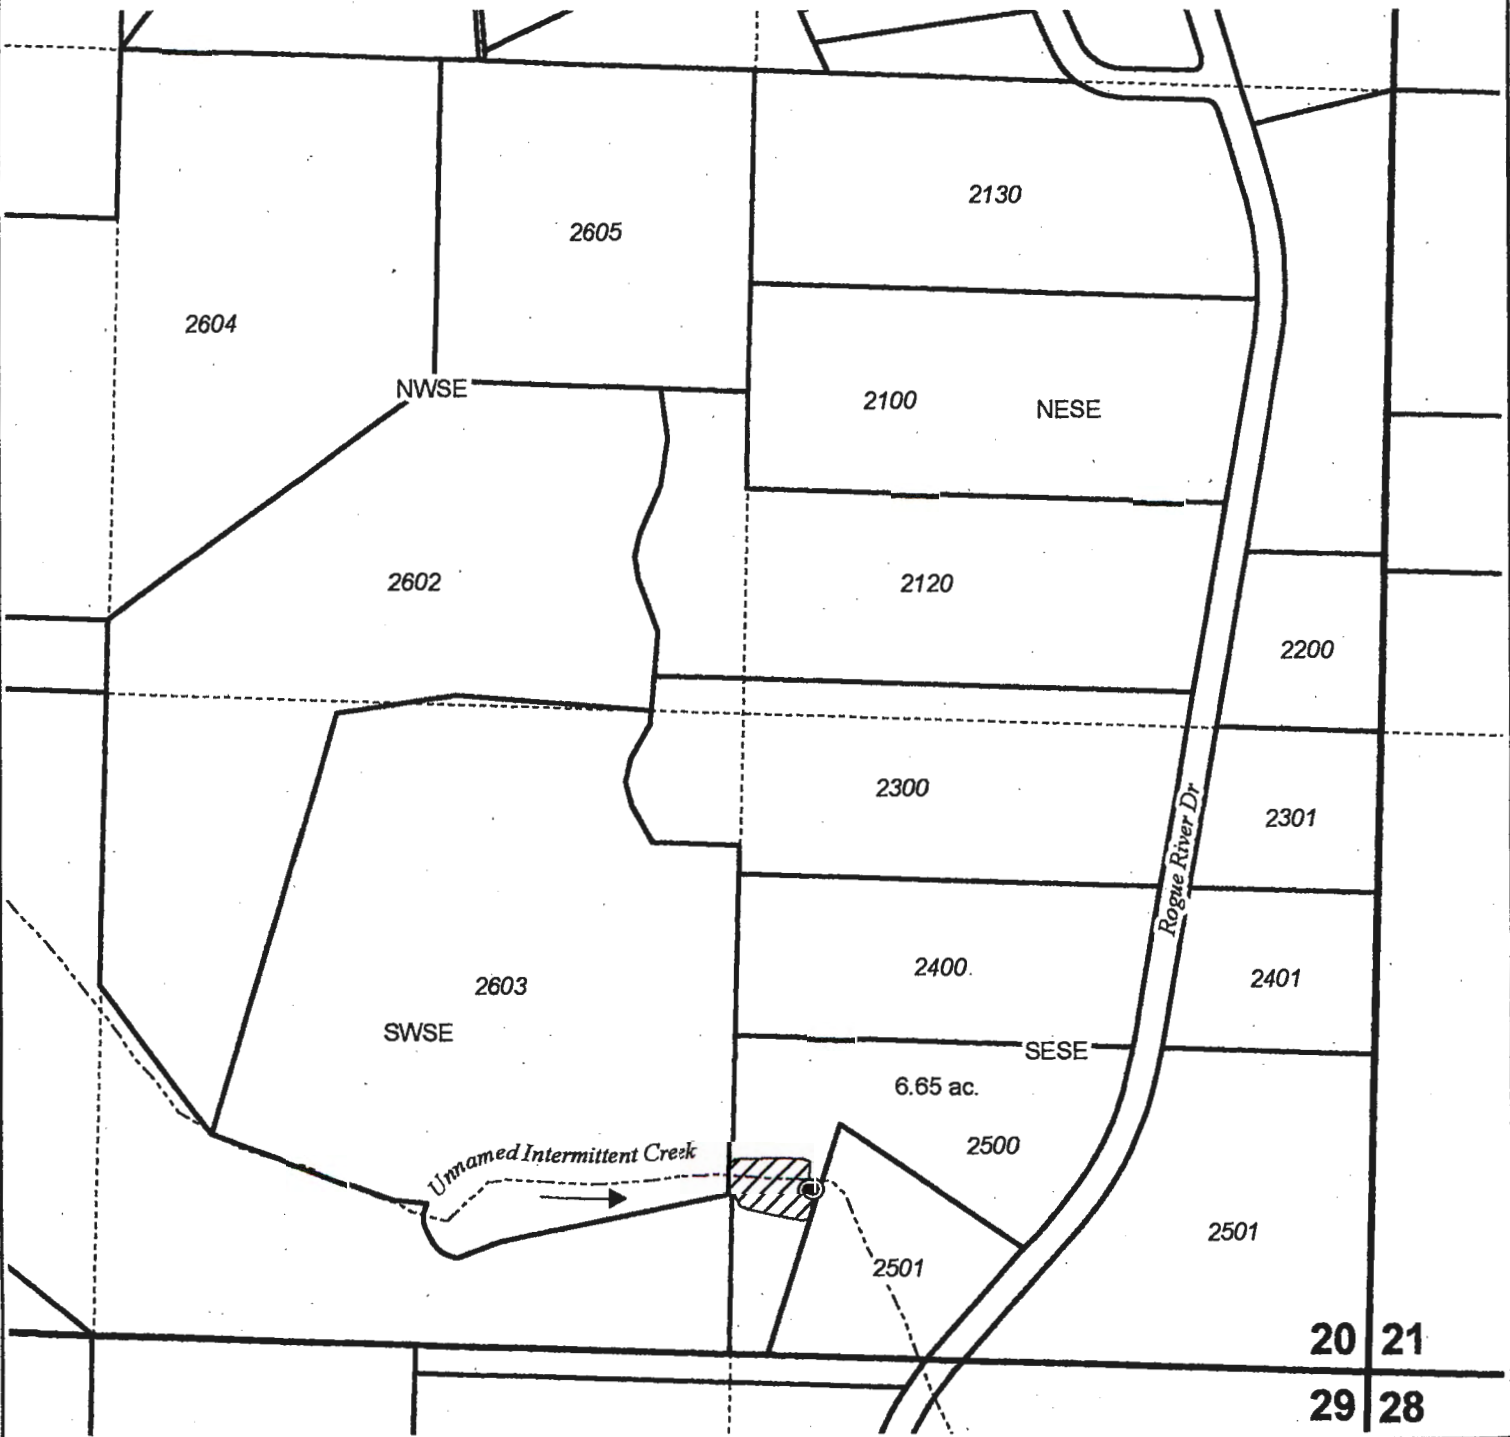

CLAIM OF BENEFICIAL USE MAP
Ronald White

This map is not intended to provide legal dimensions or locations of property ownership lines.

WATER RIGHT SERVICES, LLC
PO BOX 1830, BEND, OR 97709
WWW.OREGONWATER.US CCB # 197121
johnshort@usa.com 541-389-2837

Ap R-88671 Permit R-15374

Date: 11/22/2021