


RECEIVED

DEC 27 2021

Claim of Beneficial Use
Kongsore, Bente
Permits R-15455, R-15456, R-15457

OWRD

Township 19S, Range 4W, W.M.

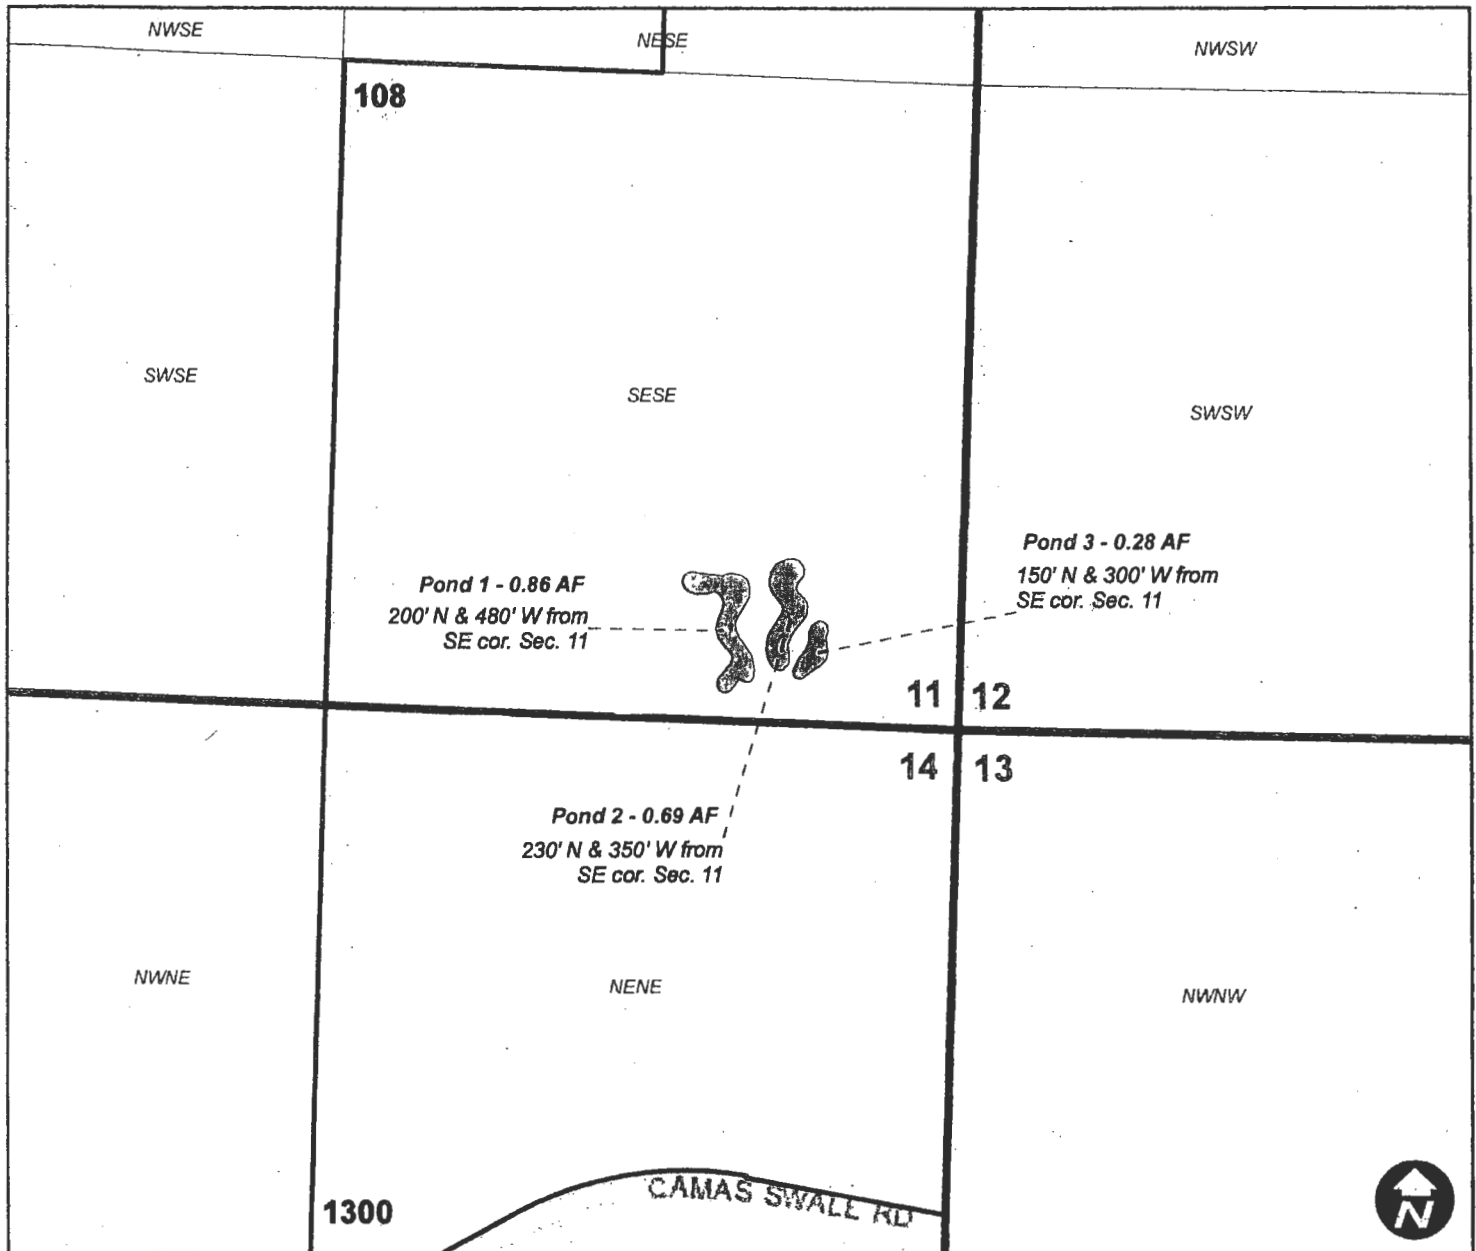

This map is not intended to provide legal dimensions or locations of property ownership lines.



Legend

-  POU (Reservoirs)
-  Tax Lot