


RECEIVED

SEP 30 2021

SECTION 36, T35S, R14W, W.M.
CURRY CO. OREGON

OWRD

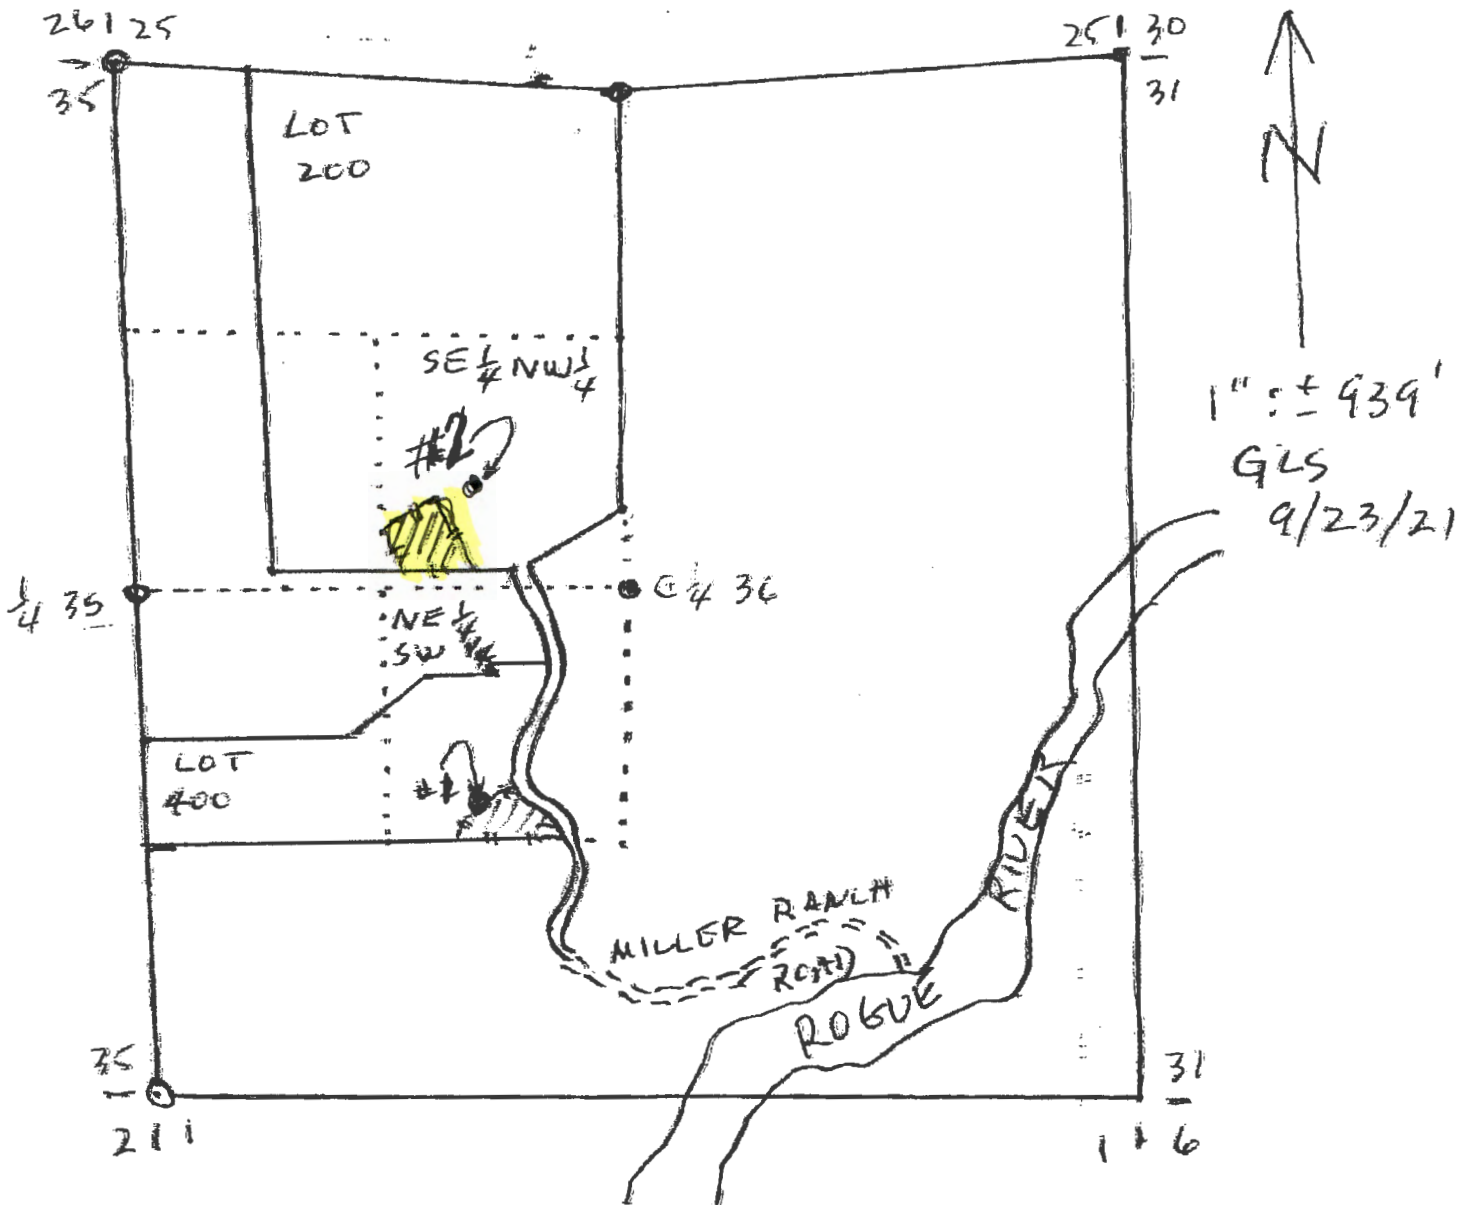

#2 DAM APEX 520' NORTH and 740' WEST
 5.0 Acre-Feet - C 1/4 SEL 36
 Lot 200 - Application 88760

~~#1 DAM APEX 1560' North and 1560' EAST
 10 Acre Feet SW COR. SEL 36~~
 N/A ~~Area of USE~~

Revised/Clarified
 WRD/NLL
 12-13-2022