


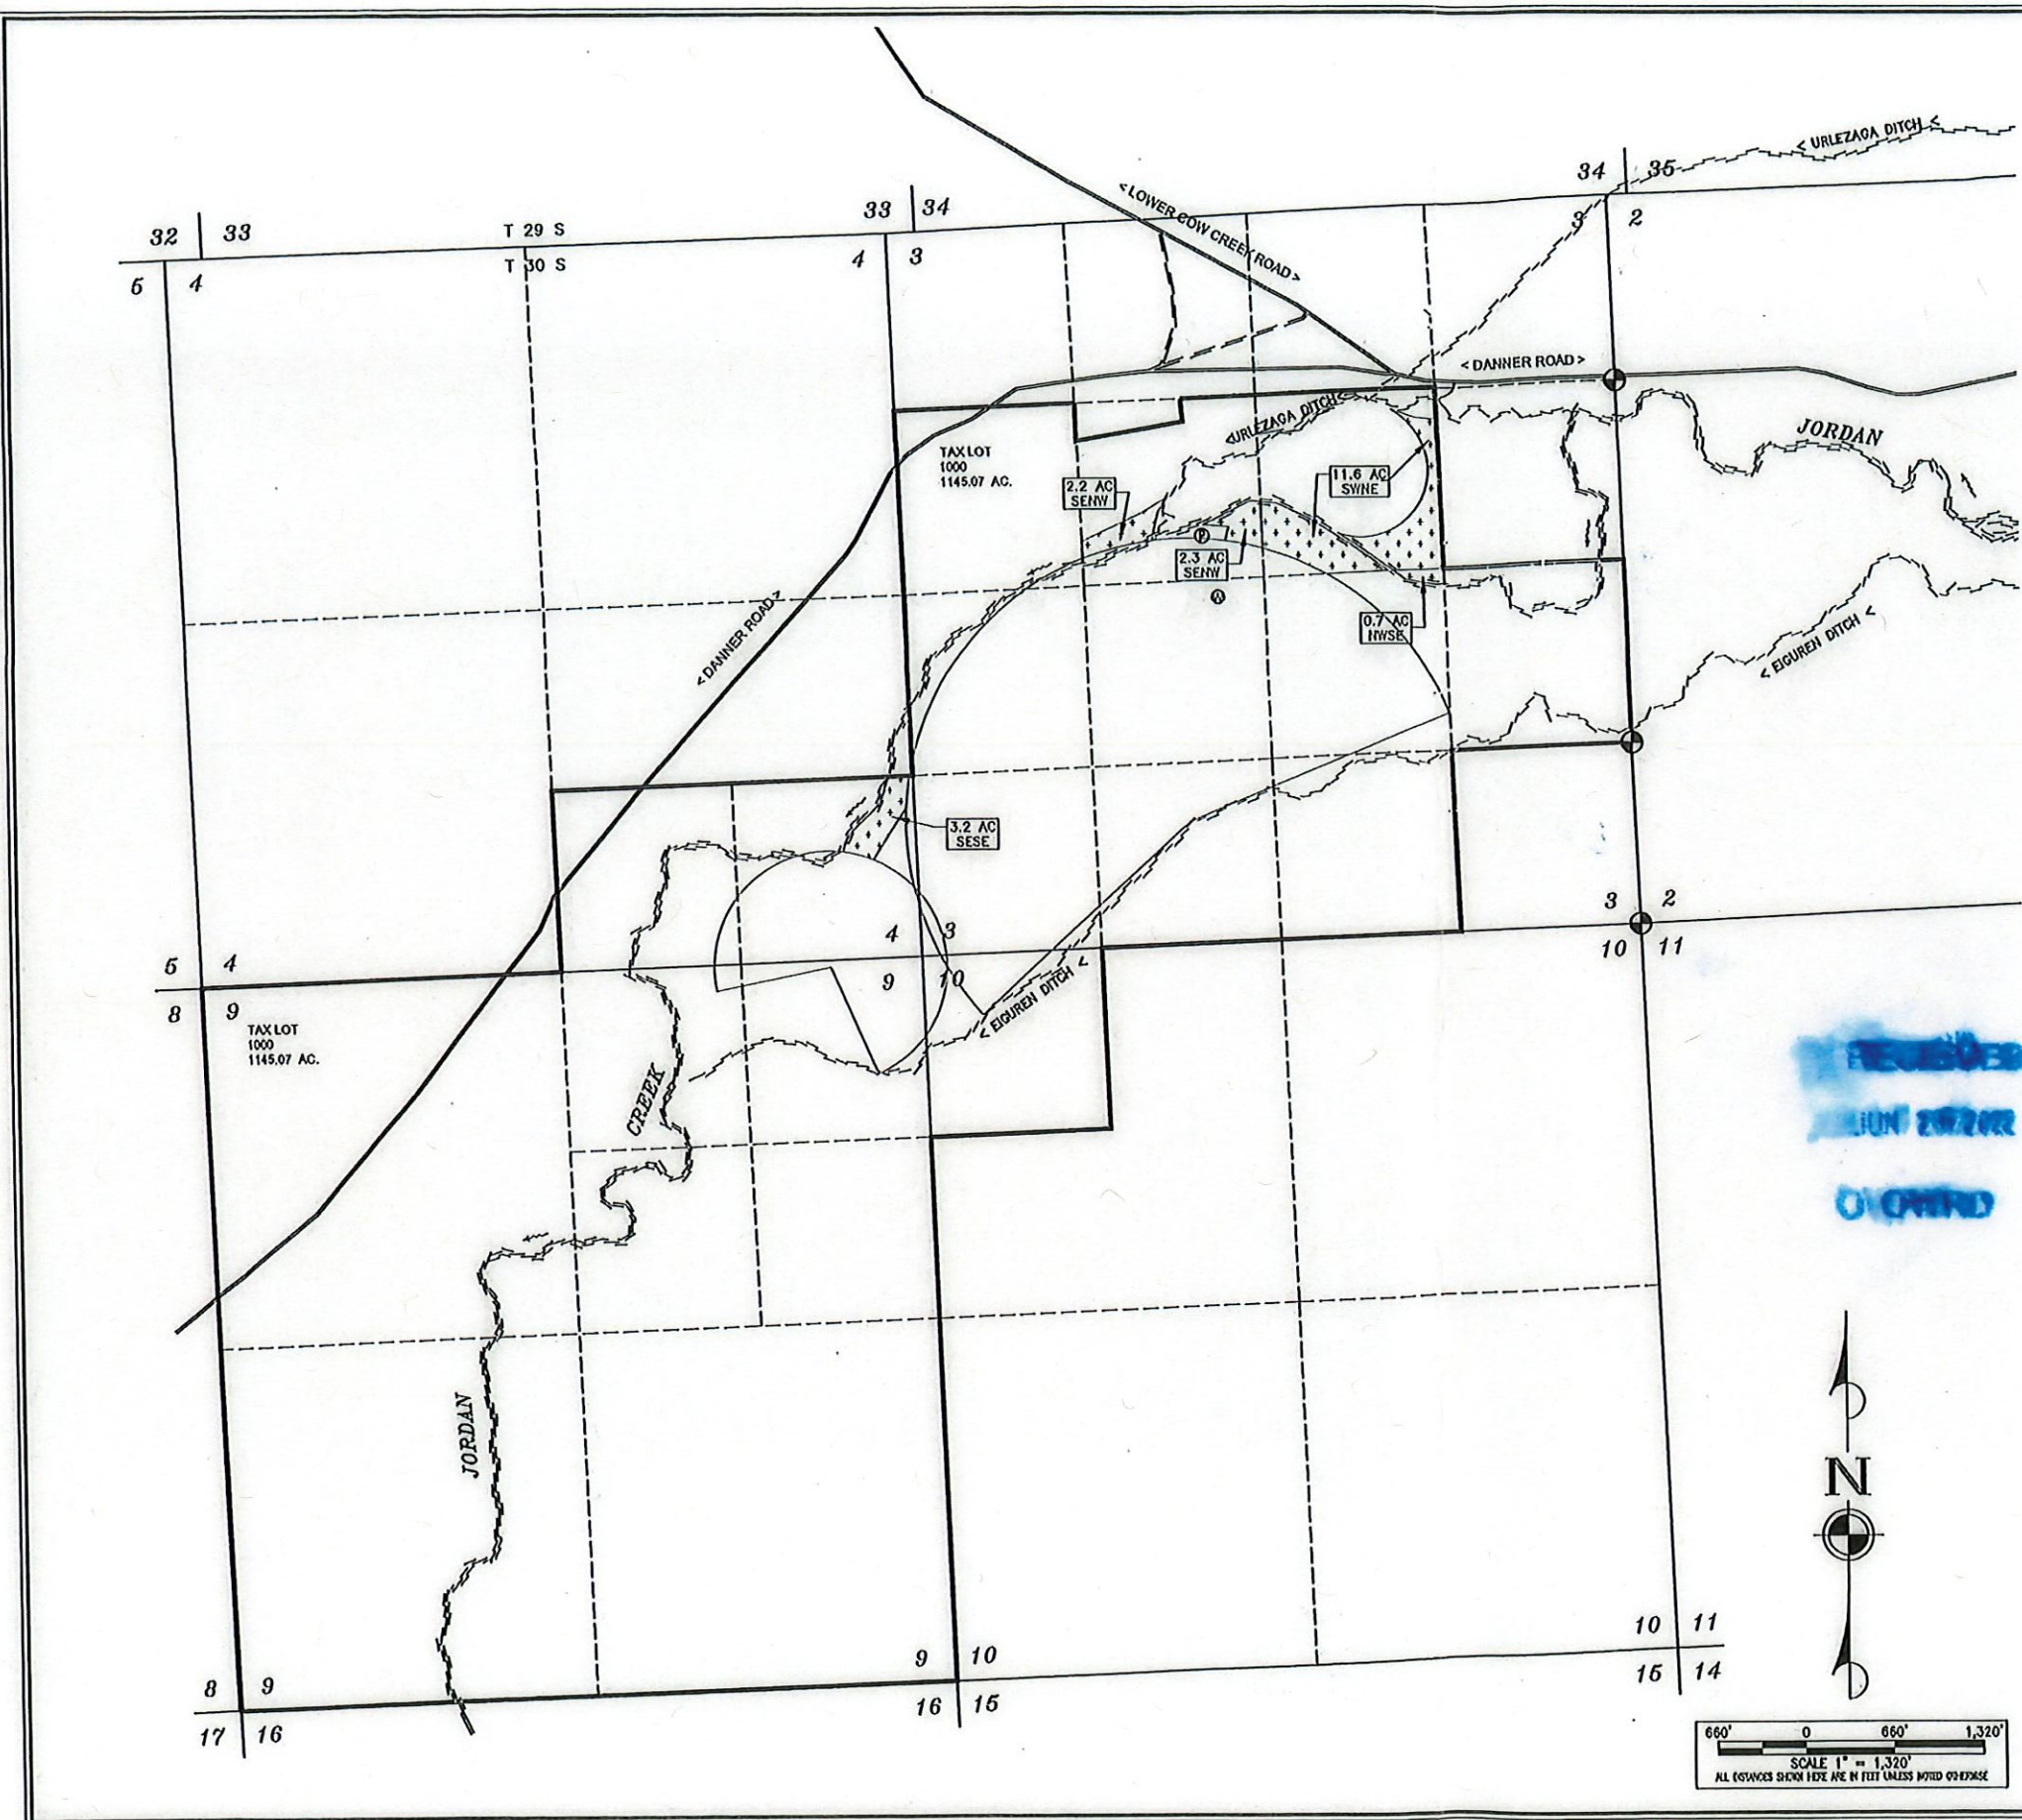

LEGEND	
DESCRIPTION	SYMBOLS
SECTION CORNER	
RECOGNIZED SURVEY CORNER	
PUMP	
WELL	
SECTION LINE	
QUARTER-QUARTER LINE	
TAX LOT LINE	
RIVER	
WATER RIGHT AREAS PLACE OF USE	
	20.0 ACRES

AUTHORIZED POINT OF DIVERSION LOCATIONS:

450' SOUTH & 700' EAST OF THE
NORTHWEST CORNER OF SECTION 5
T. 30 S., R. 46 E., W.M.

2,340' SOUTH & 2,250' EAST OF THE
NORTHWEST CORNER OF SECTION 3
T. 30 S., R. 45 E., W.M.

RECEIVED
JUN 17 2014
CLERK

CERTIFIED WATER RIGHT EXAMINER
#85283WRE
Pat J. Woodcock
PAT J. WOODCOCK
JUNE 17, 2014
STATE OF OREGON

RENEWS: 6/30/2022

DISCLAIMER:
THIS MAP WAS MADE TO BE A PART OF THE
CLAIM OF BENEFICIAL USE FOR A WATER RIGHT.
SECTIONAL LINES SHOWN ARE APPROXIMATE AND
THIS MAP IS NOT INTENDED FOR ANY OTHER USE
AND DOES NOT GUARANTEE LAND OWNERSHIP.

IF THIS BAR SCALE
DOES NOT MEASURE 1"
THEN THIS DRAWING
IS NOT TO SCALE

Reviewed By: PAT J. WOODCOCK
Drawn By: PJW
Print Date: June 14, 2022
DWG. Scale: AS SHOWN

CLAIM OF BENEFICIAL USE MAP
TRANSFER No. T-12365
CERTIFICATE No. 56246
MALHEUR COUNTY, OREGON

CHUCK PIPPUS
1850 DANNER LOOP ROAD
JORDAN VALLEY, OREGON 97910

ENGINEERING NORTHWEST, LLC
11 NW 9th Street
Ontario, Oregon 97914
www.engineeringnw.com (541)889-4432

W1
SHEET NO. 1 OF 3
JOB NO. 17000-26