


**Claim of Beneficial Use Map
Application T-12526
for
Edward M. Ginochio**

RECEIVED

MAY 28 2021

OWRD

T 39 S, R 18 W
Sec 25 & 26

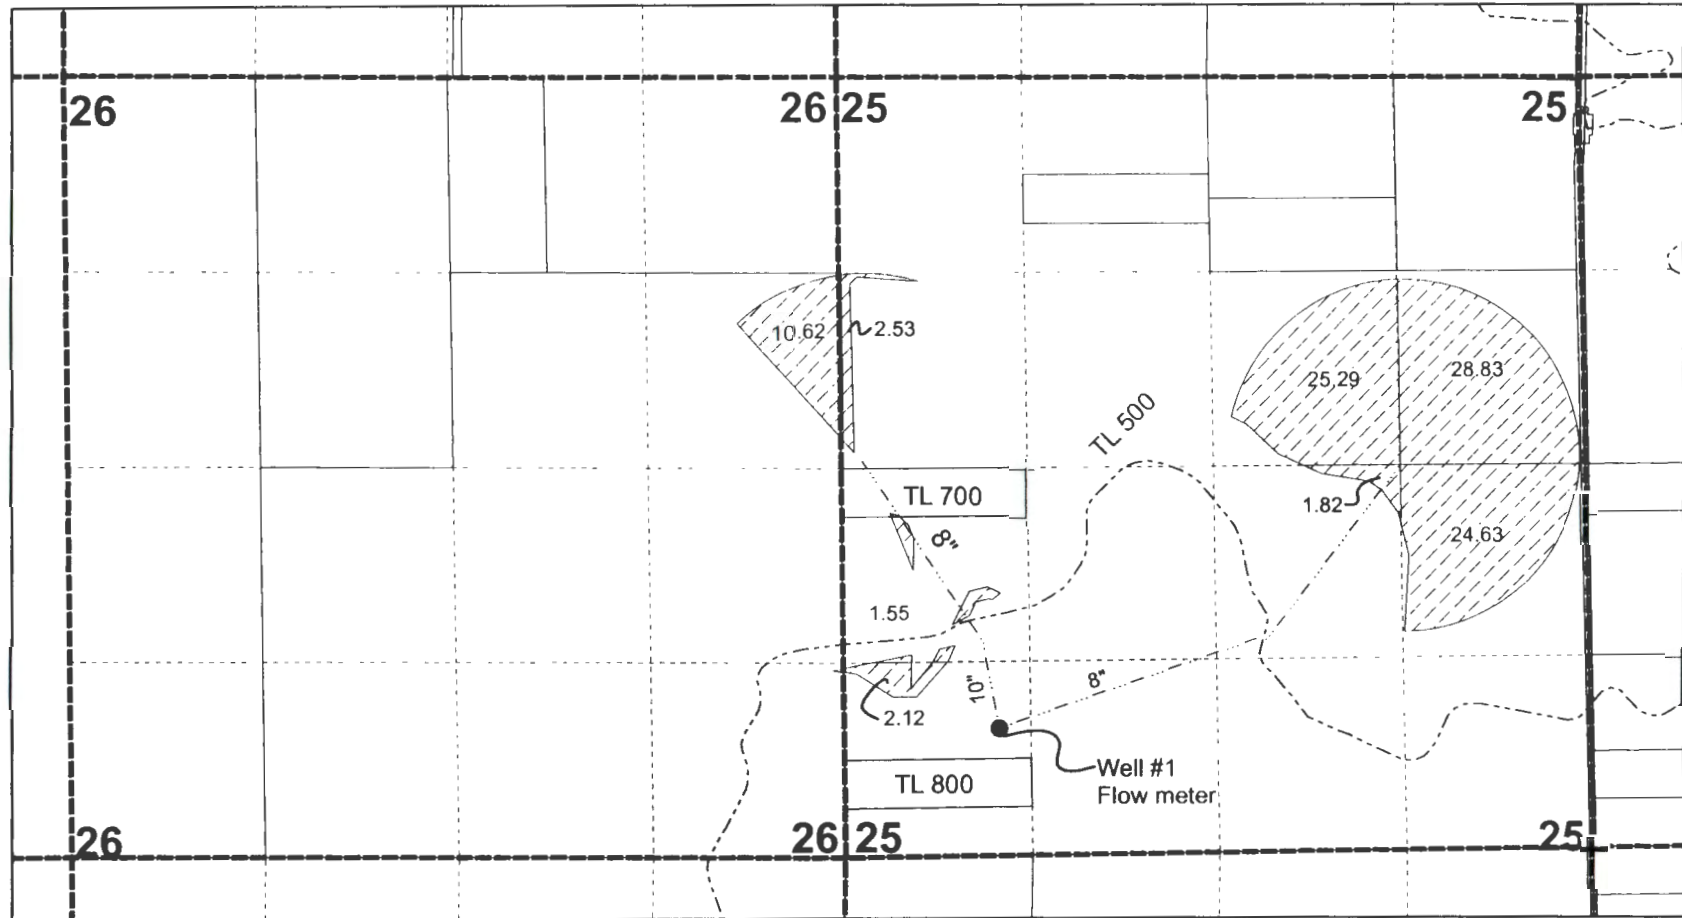

1 inch = 1,320 feet

Legend

-  T-12526 area irrig 97.39 ac
-  Well #1 & Flow meter
-  Buried Pipeline
-  Existing Cert 93338
-  LWU Canal

POA is Well #1
LAKE 2141
940 ft N & 890 ft E
Fm SW Cor Sec 25

Note: This map is not intended
to provide legal dimensions or
locations of property ownership
lines.

