


T.4S. R.1W. Sec. 22 & 23, W.M.


Handwritten: June 30 2023

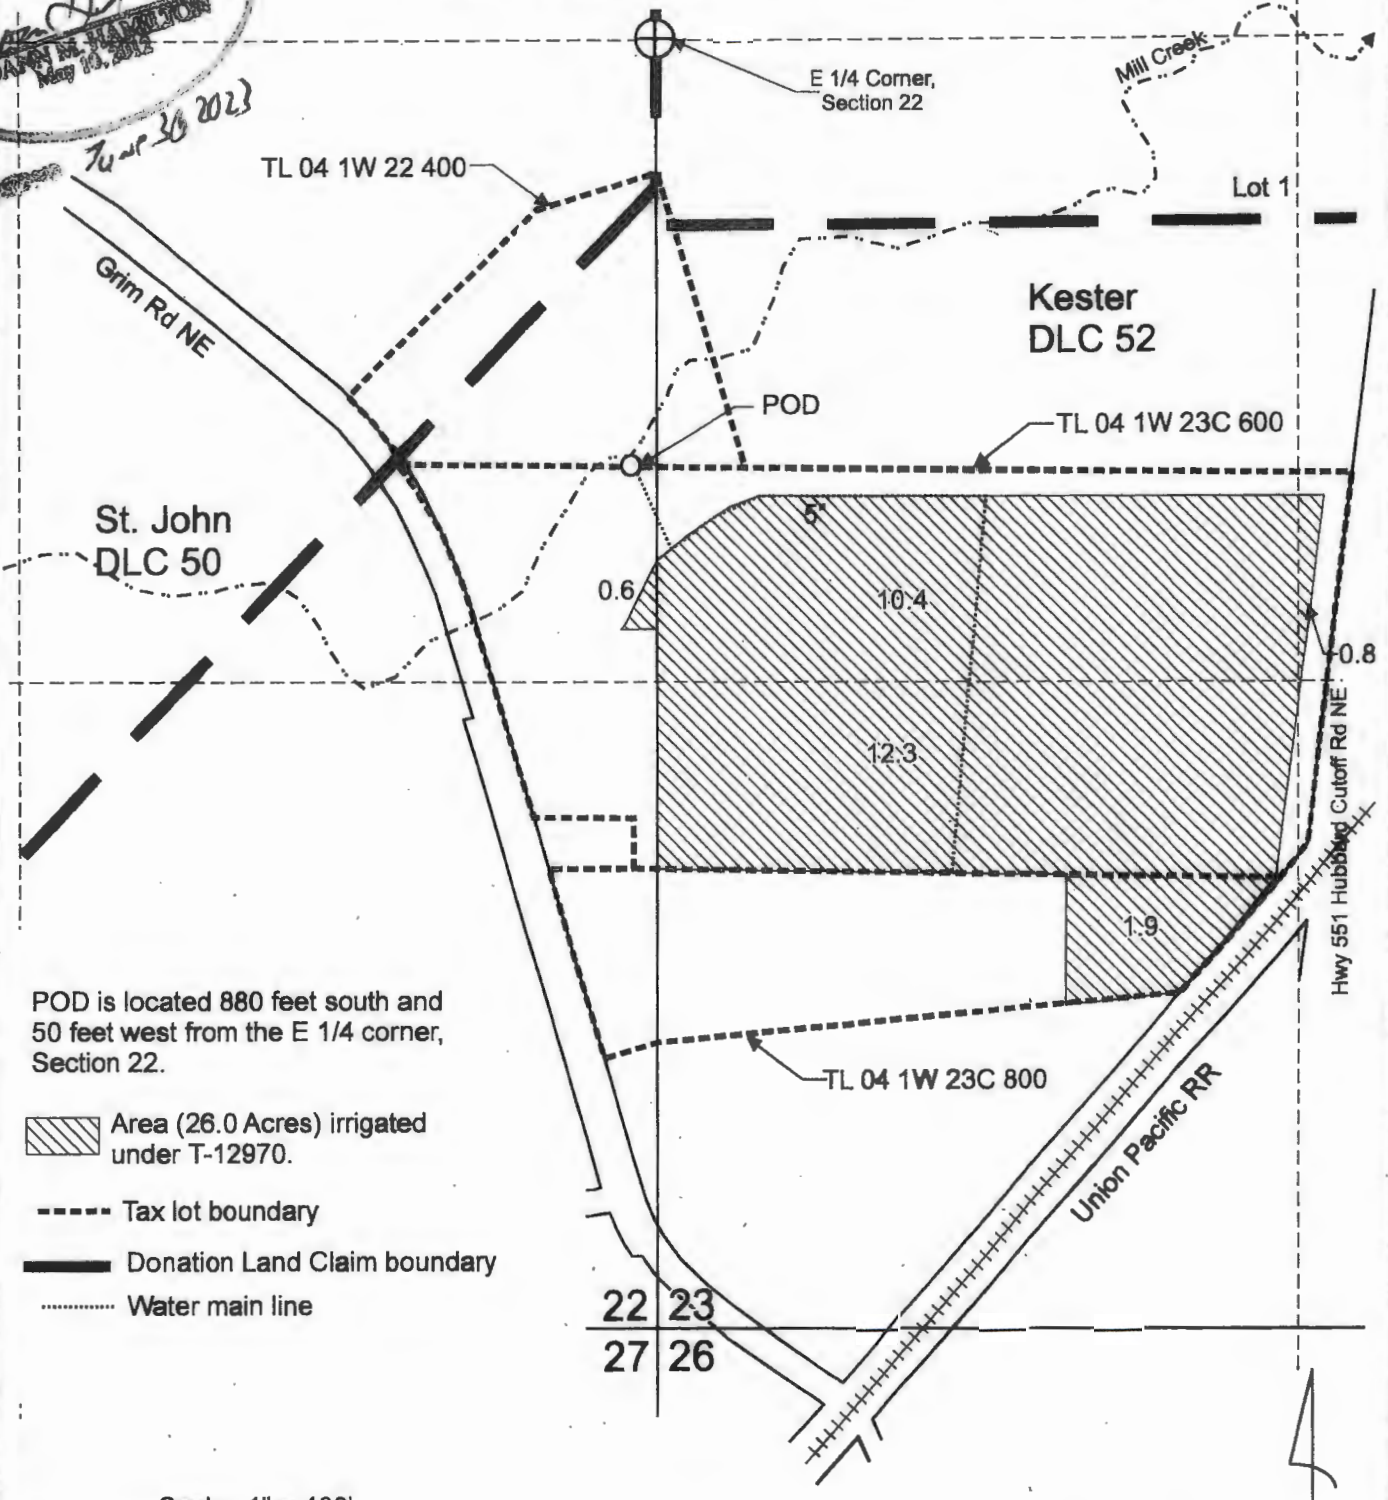

POD is located 880 feet south and 50 feet west from the E 1/4 corner, Section 22.

- Area (26.0 Acres) irrigated under T-12970.
- Tax lot boundary
- Donation Land Claim boundary
- Water main line

Scale: 1" = 400'

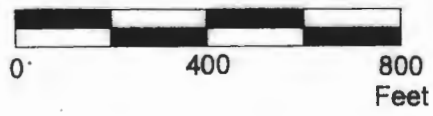

This map was prepared for the purpose of identifying the location of a water right only and is not intended to provide legal dimensions or location of property ownership lines.

Claim of Beneficial Use Map
 T-12970

Bruce Ernst
 T.4S. R.1W. Sec. 22 & 23, W.M.

Pacific Hydro-Geology Inc.

06/2021

RECEIVED
 JUN 30 2021
 06/30

ErnstHubbardT-12970COBUMap.cdr