

**Claim of Beneficial Use, Place of Use and  
 Point of Appropriation Map for Irrigation Use  
 Application G-13264  
 Permit G-17516  
 Permit Amendments T-9601, T-10269, and T-11992**


CERTIFIED WATER RIGHTS EXAMINER STAMP




**RECEIVED**  
 FEB 15 2022  
 OWRD

**DISCLAIMER**  
 This map was prepared for the purpose of identifying the location of a water right only and it is not intended to provide legal dimensions or location of property ownership lines.

Date: January 14, 2022  
 Data Sources: BLM, ESRI, OWRD, USGS

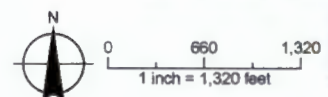

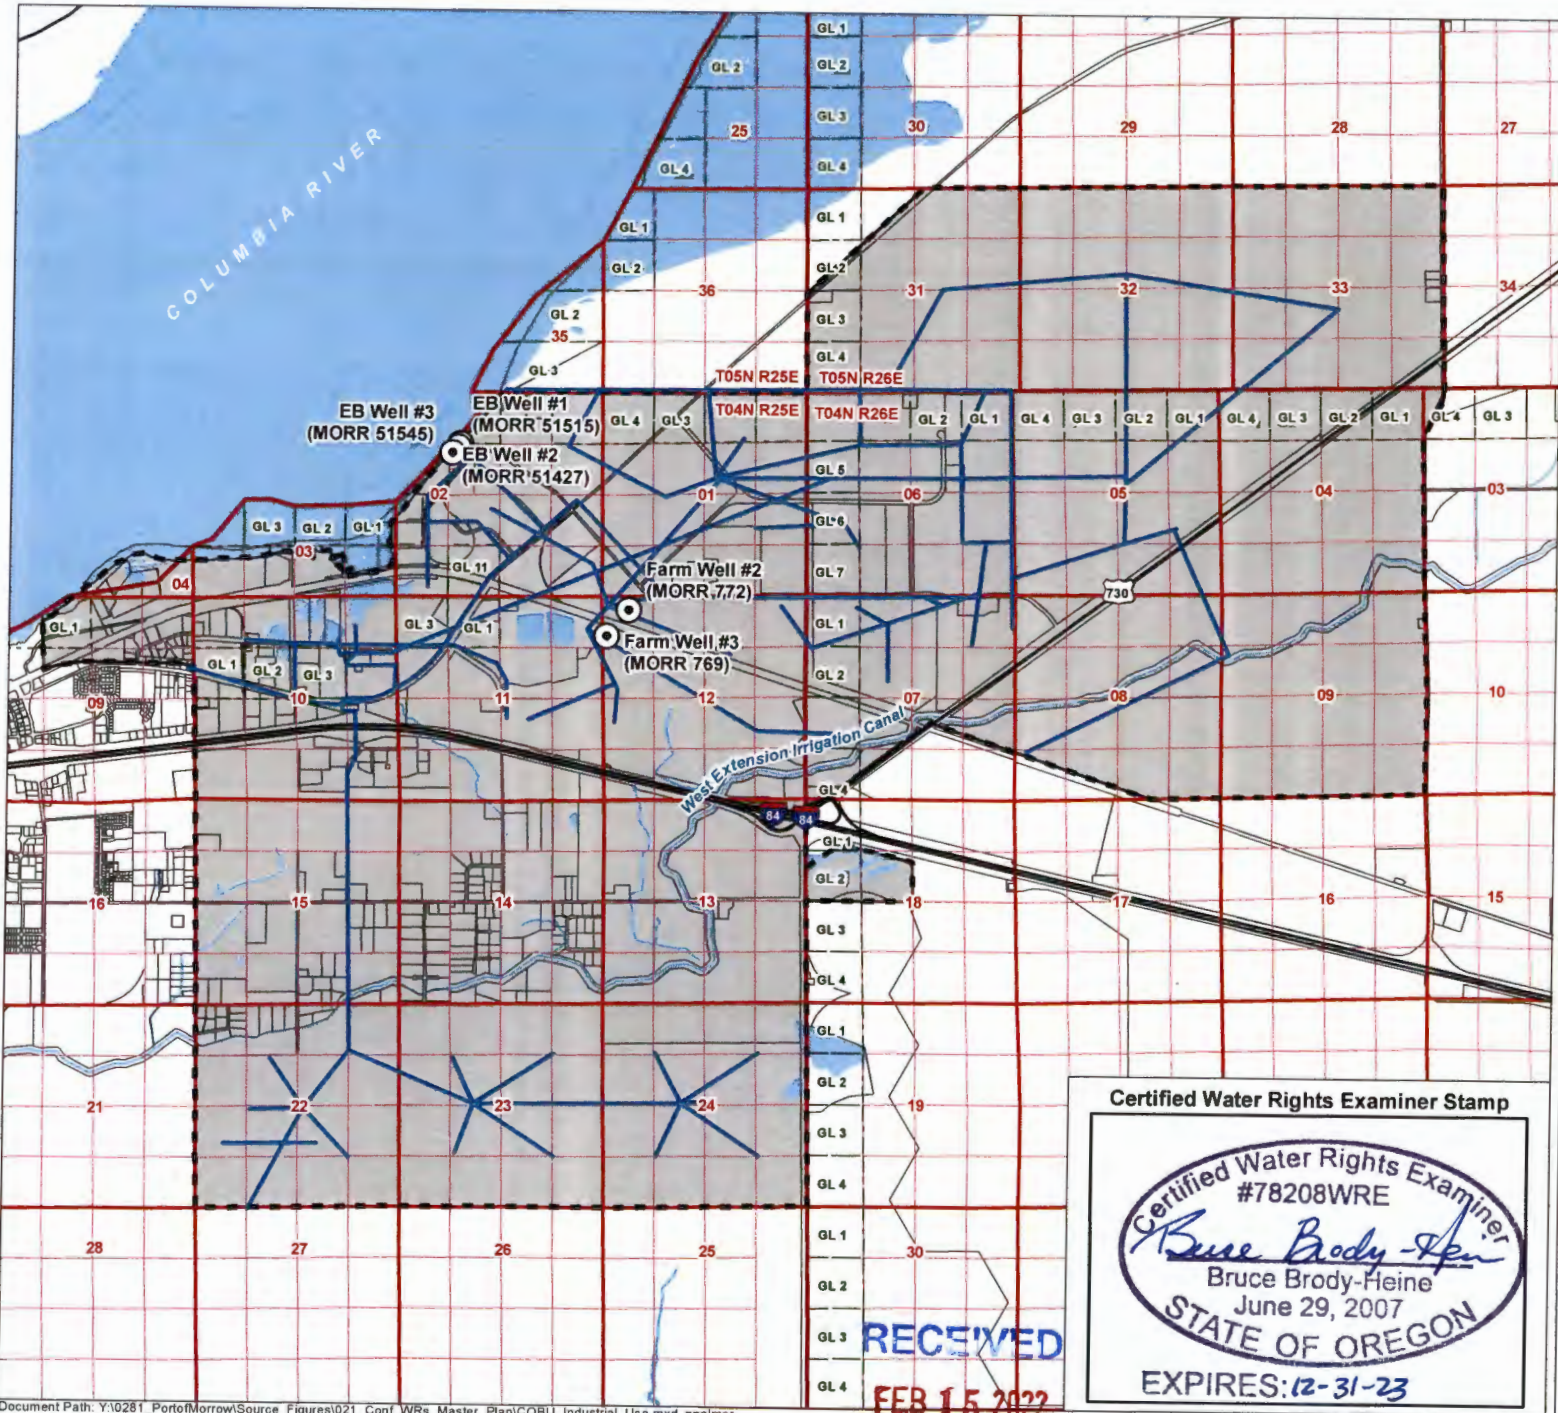

**Claim of Beneficial Use  
Place of Use and  
Point of Appropriation Map  
for Industrial Use**

**Application G-13264  
Permit G-17516  
Permit Amendments  
T-9601, T-10269, & T-11992**

**Port of Morrow**

- LEGEND**
- Point of Appropriation
  - Pipeline
  - ▭ Industrial Place of Use (POU), Port Service Area Boundary
  - ▭ Tax Lot
  - ⌈⌋ Government Lot (GL)
  - Major Road
  - ~ Watercourse
  - Waterbody
- All Other Features**

**POA LOCATION DESCRIPTION**

**EB Well #1 (MORR 51515)** Located 1377 feet South and 3659 feet West from the NE Corner of Section 2, Township 4 North, Range 25 East (W.M.)  
Meter Located 40.8' South and 14.8' West of EB Well #1.

**EB Well #2 (MORR 51427)** Located 1448 feet South and 3724 feet West from the NE Corner of Section 2, Township 4 North, Range 25 East (W.M.)  
Meter Located 4.0' South and 8.5' East of EB Well #2.

**EB Well #3 (MORR 51545)** Located 1590 feet South and 3845 feet West from the NE Corner of Section 2, Township 4 North, Range 25 East (W.M.)  
Meter Located 8.5' South and 9.3' East of EB Well #3.

**Farm Well #2 (MORR #772)** Located 338 ft South and 691 ft East from the NW corner of Section 12, Township 4 North, Range 25 East (W.M.)  
Meter located 12.5' North and 8.9' West of Well

**Farm Well #3 (MORR #769)** Located 1030 ft South and 120 ft East from the NW corner of Section 12, Township 4 North, Range 25 East (W.M.)  
Meter located Dedicated electrical meter is located 10 feet to West of well

**Certified Water Rights Examiner Stamp**

Certified Water Rights Examiner  
#78208WRE  
*Bruce Brody-Heine*  
Bruce Brody-Heine  
June 29, 2007  
STATE OF OREGON  
EXPIRES: 12-31-23

**DISCLAIMER**

This map was prepared for the purpose of identifying the location of a water right only and it is not intended to provide legal dimensions or location of property ownership lines.

N  
0 2,500 5,000  
1 inch = 5,000 feet

Date: January 28, 2022  
Data Sources: USGS, BLM, OWRD,  
R.V. McKinnis Engineering

Document Path: Y:\0281\_PortofMorrow\Source\_Figures\021\_Conf\_WRs\_Master\_Plan\COBU\_Industrial\_Use.mxd, npalmer