


Claim of Beneficial Use in the Name of ABG Oregon Vineyards LLC Place of Use and Point of Diversion

Application R-88858, Permit R-15474
Yamhill County
Township 2 South, Range 4 West (W.M.)

RECEIVED


JAN 23 2023

OWRD

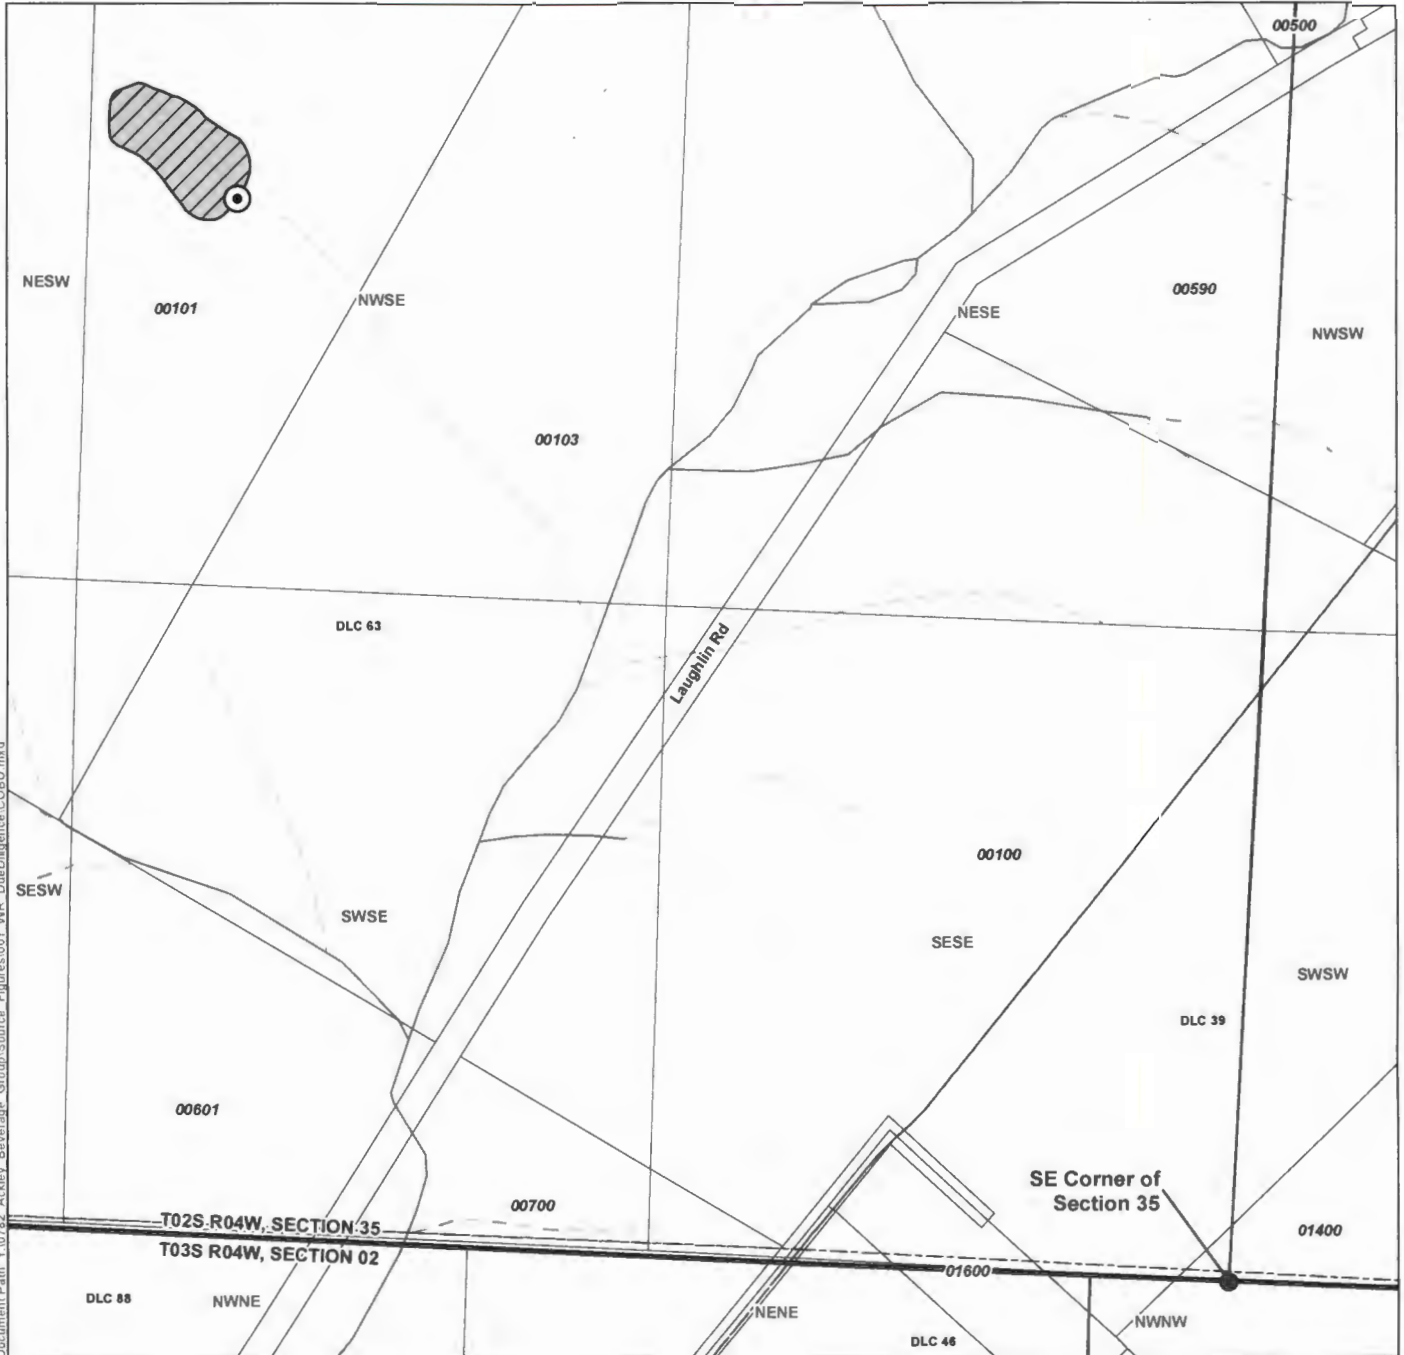

Document Path: Y:\0782_Ackley Beverage_Group\Source_Figures\01_WF_DueDiligence\COBU.mxd

Certified Water Rights Examiner Stamp

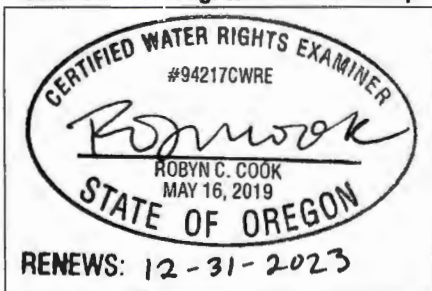

LEGEND

- Center of Dam
- Place of Use (POU)
- Tax Lot
- Donation Land Claim (DLC)
- Watercourse
- Waterbody

POD LOCATION DESCRIPTION

Point of Diversion located 2,140 feet North and 2,180 feet West from the SE corner of Section 35, Township 2 South, Range 4 West (W.M.)

DISCLAIMER

This map was prepared for the purpose of identifying the location of a water right only and it is not intended to provide legal dimension or location of property ownership lines.

MAP NOTES

Date: January 17, 2023
Data Sources: ESRI, OWRD, BLM, Yamhill Co, OGIC

