T18S R11E, WM
DESCHUTES COUNTY, OR

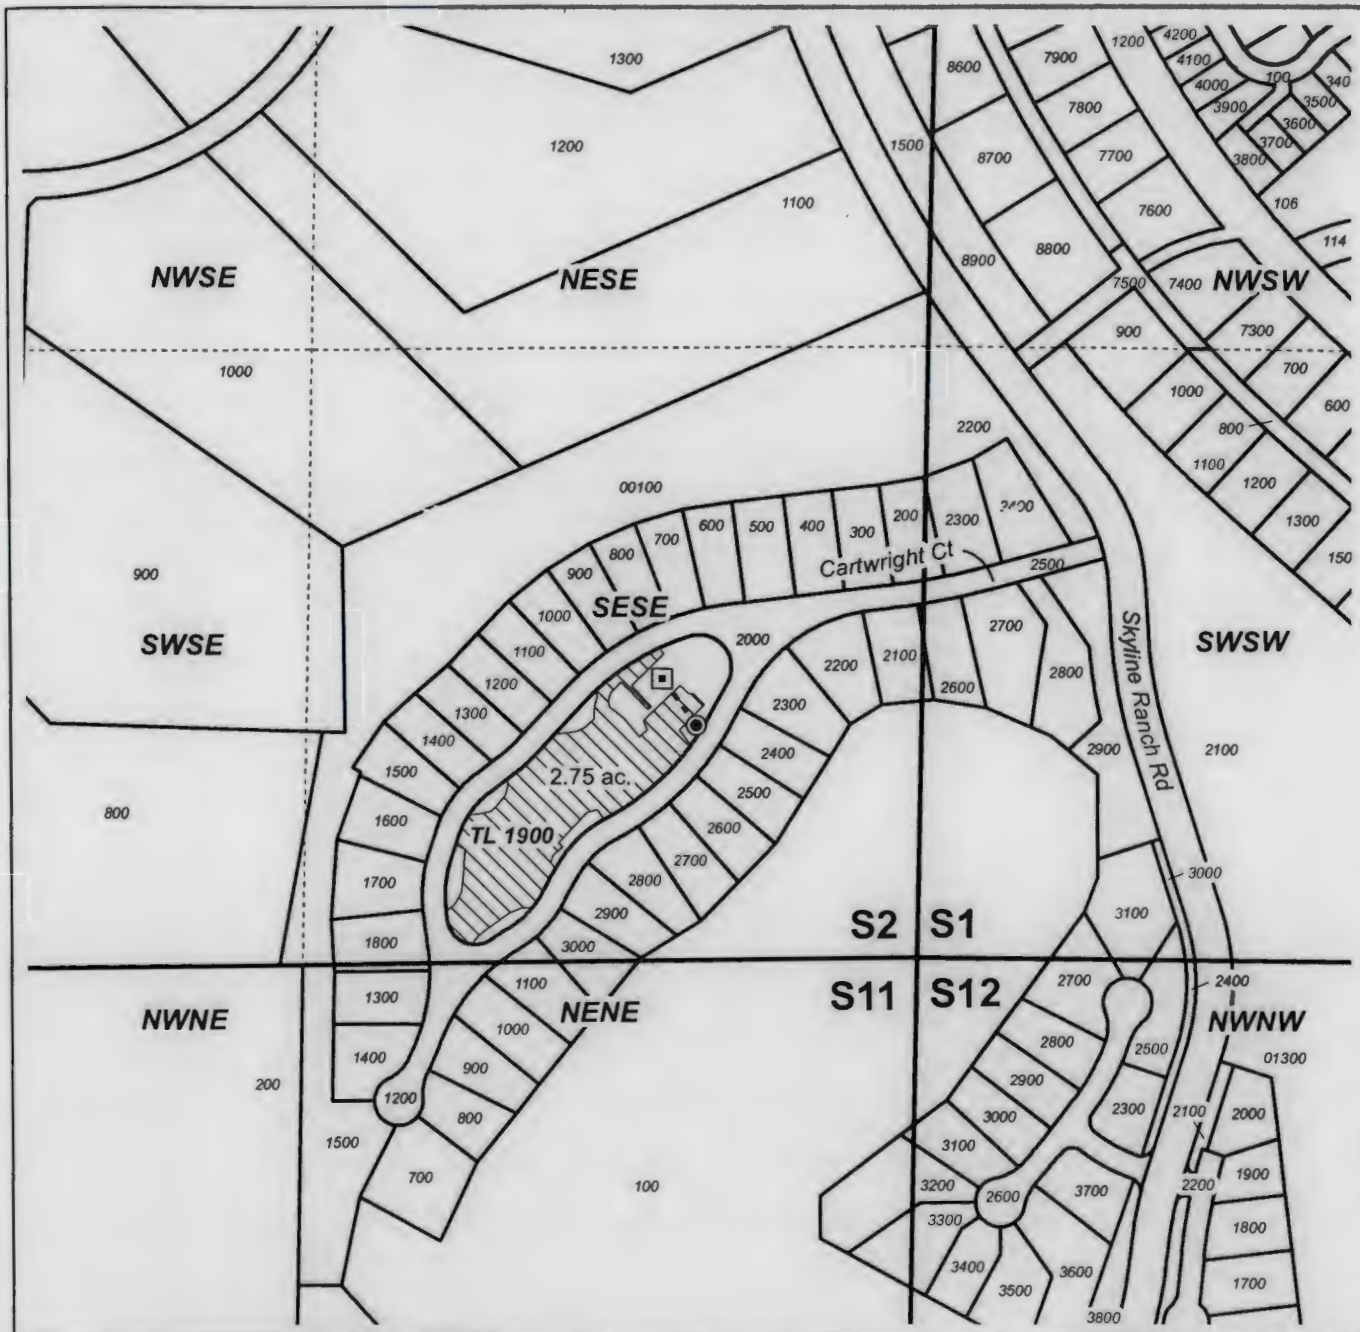

0 400 Feet

1" = 400'

- Well
- Meter
- Pipeline
- POU IR
- Section
- Quarter Quarter
- Tax Lot

Well (DESC 61056/L-127062) Location:
505' N', 476' W of the SE Cor Sec 2

RECEIVED
FEB 22 2022
OWRD

Certified Water Right Examiner
033
Gary L. DeJarnatt
Nov. 19, 1987
STATE OF OREGON

RENEWAL DATE 12/31/2023

CLAIM OF BENEFICIAL USE MAP
Tartan Druim HOA

AP G-18397 PERMIT G-18190 PROJECT #21049

Date: 2/2/2022

This map is not intended to provide legal dimensions or locations of property ownership lines.

WATER RIGHT SERVICES, LLC
PO BOX 1830, BEND, OR 97709
WWW.OREGONWATER.US CCB # 197121
johnshort@usa.com 541-389-2837