



FINAL PROOF MAP

TO CHANGE PLACE OF USE
FOR TRANSFER T-11471
MEADOW CREEK ENTERPRISES

TOWNSHIP 23SOUTH, RANGE 27 EAST, SECTION 7, W.M.
TAX LOT: 200

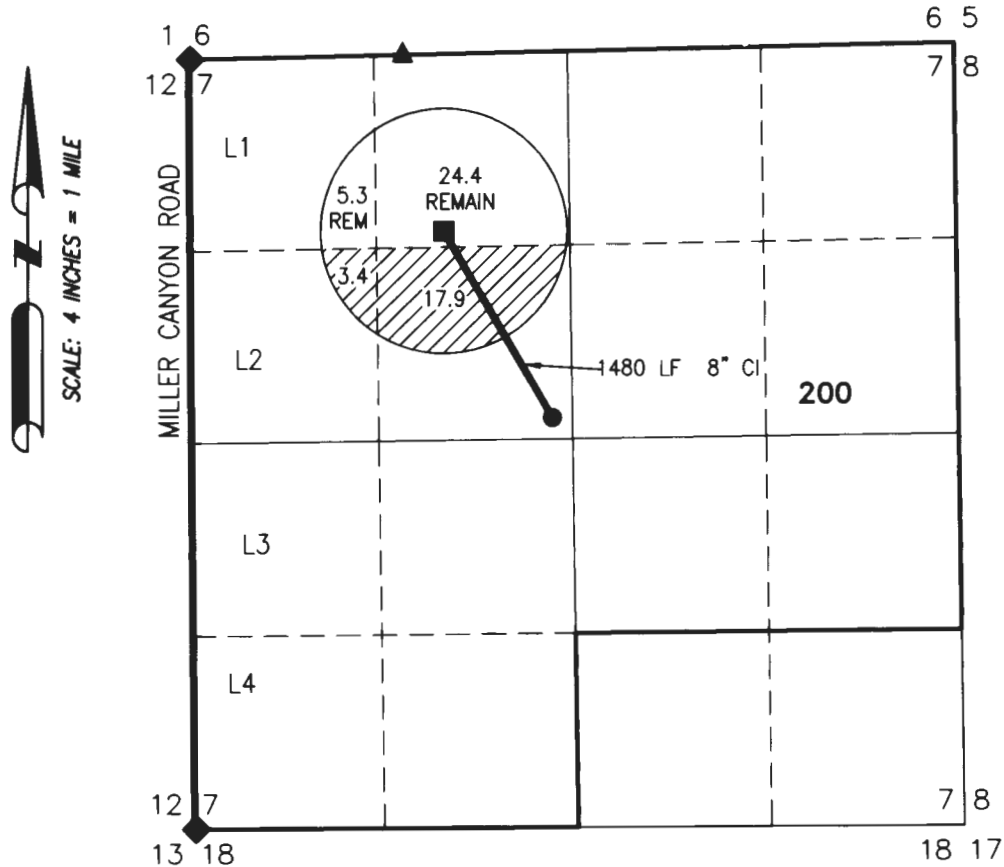

RECEIVED
OCT 15 2018
OWRD

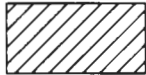

21.3 ACRES PRIMARY RIGHTS FROM POD & POA
PER T-11471 (S-43009 & G-8055), AS SHOWN.



RENEWAL DATE: 12/31/2018

POD (G#60961)

LOCATED IN THE NE 1/4 NW 1/4 SECTION 7, T23S R27E, W.M.
AND 0 FEET SOUTH AND 1450 FEET EAST FROM THE NW CORNER
OF SECTION 7.

POA (G#60960)

LOCATED IN THE SE 1/4 NW 1/4 SECTION 7, T23S R27E, W.M.
AND 2820 FEET NORTH AND 2440 FEET EAST FROM THE SW
CORNER OF SECTION 7.

THIS MAP IS FOR THE PURPOSE OF LOCATING A WATER RIGHT ONLY AND HAS NO
INTENT TO PROVIDE LEGAL DIMENSIONS OR THE LOCATION OF PROPERTY LINES.

PREPARED FOR:

MEADOW CREEK ENTERPRISES
67337 SILVER CREEK ROAD
RILEY, OR 97725

PREPARED BY:



ALL POINTS ENGINEERING AND SURVEYING, INC.
P.O. BOX 767
(541) 548-5833
TERREBONNE, OR 97760
www.APEandS.com