


Claim of Beneficial Use

Sidney Irrigation Cooperative / US Fish and Wildlife Service

Transfer T-11545

Township 9S, Range 3W, W.M.

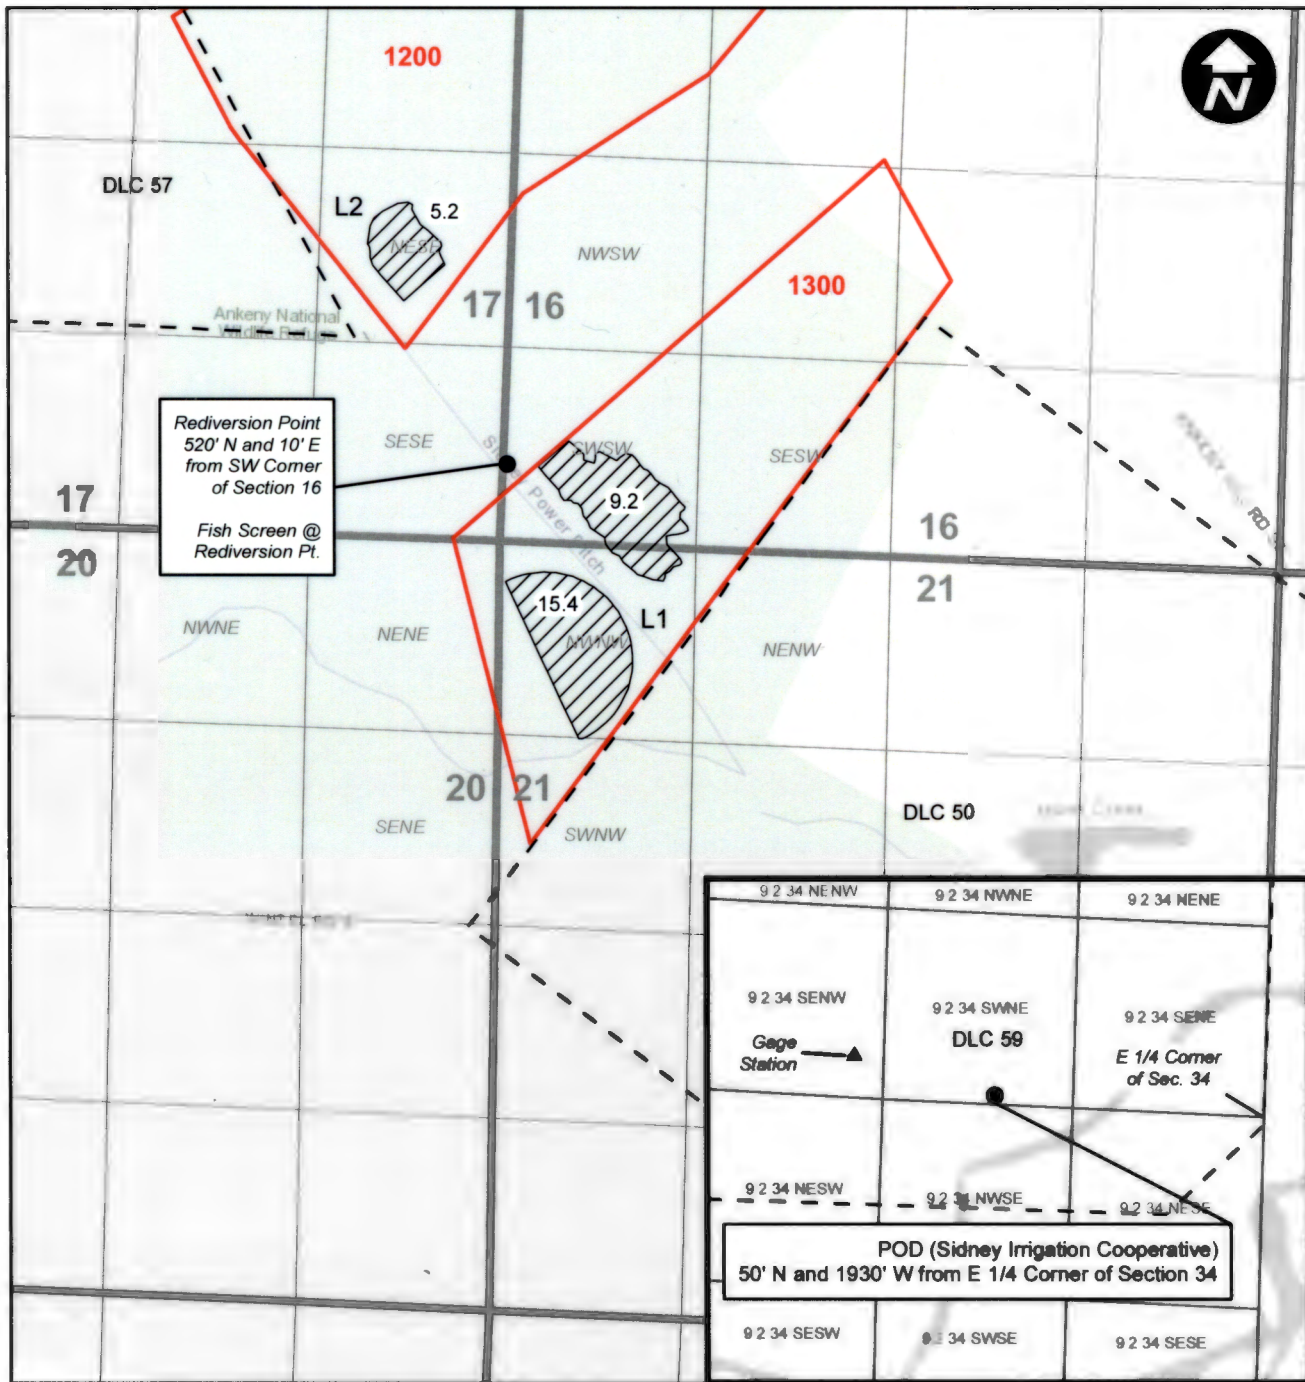




This map is not intended to provide legal dimensions or locations of property ownership lines.



EXPIRES: 12-31-2022

Legend

-  Place of Use
-  Tax Lot
-  DLC

