
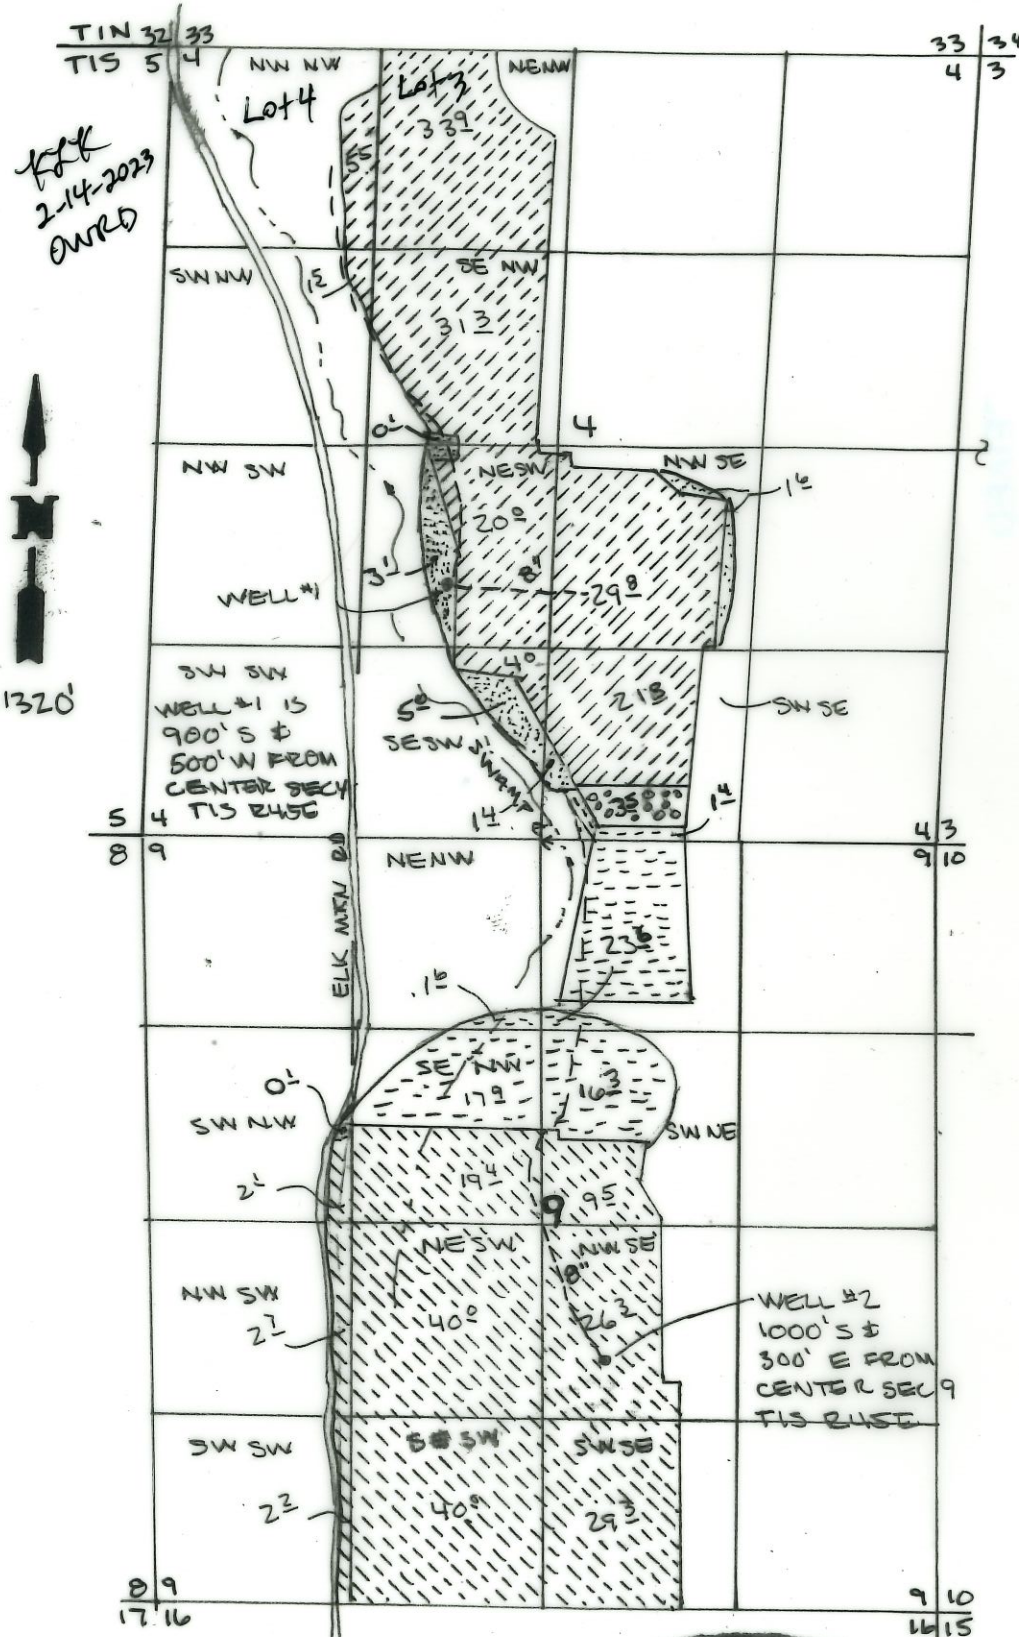


EXISTING WR'S CERTS 57802 & 57803

WATER RIGHTS PERMIT G-13367

LEGEND

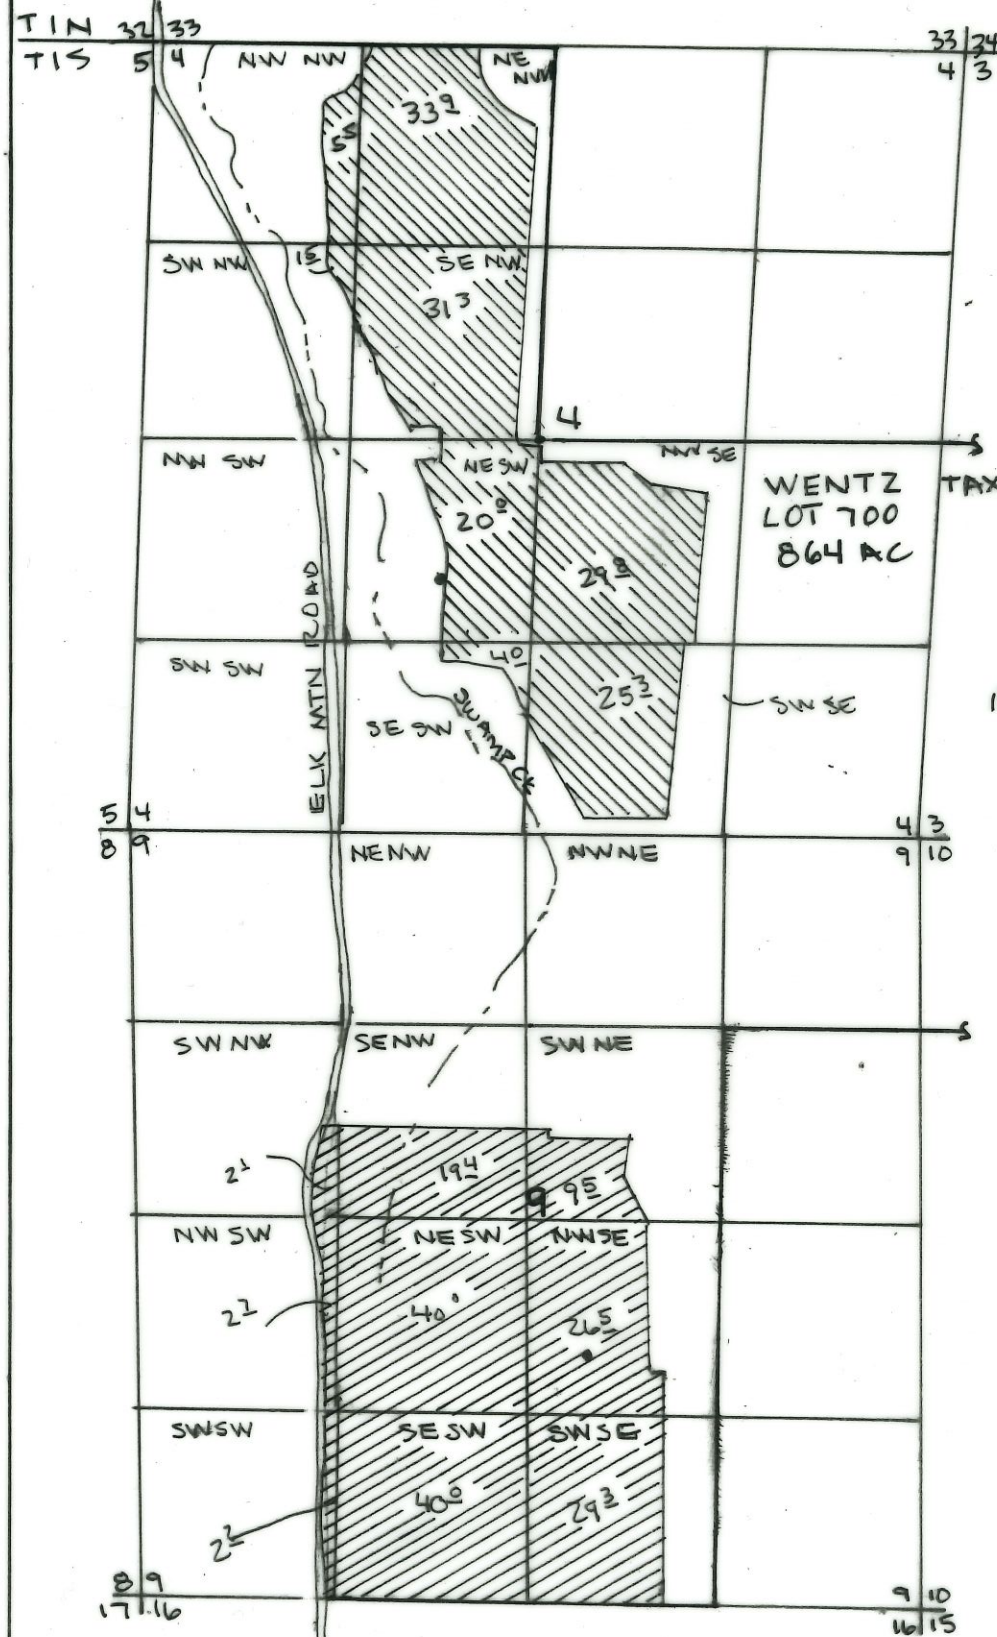

- 1976 PRIMARY WR CERT 57802
 - 1976 PRIMARY WR CERT 57803
 - 1997 SUPPLEMENTARY WR WELL #1 PERMIT G-13367
 - 1997 ADD'L PRIMARY WR WELL #1 PERMIT G-13367
 - 1997 ADD'L PRIMARY WR WELL #2 PERMIT G-13367
 - 1997 SUPPLEMENTAL WR WELL #2 PERMIT G-13367
 - 1997 SUPPLEMENTARY DEFICY IN RATE WELL #2 PERMIT G-13367
- REQ'D METERS ARE LOCATED ADJACENT TO WELLS 1 & 2

	WELL #1	
	PRIMARY	SUPPLEMENTAL DEFICY IN RATE
NENW		33.9 AC
NW NW		5.5 AC
SW NW		1.5 AC
SE NW	0.1 AC	31.3 AC
NE SW	3.1 AC	20.0 AC
SE SW	5.0 AC	4.0 AC
NW SE	1.6 AC	29.8 AC
SW SE	1.4 AC	21.8 AC
SECTION 4		TOTAL 159.0

	WELL #2	
SW SE	1.4 AC	3.5 AC
SECTION 4		
NW NE	23.6 AC	
SW NE	16.3 AC	9.5 AC
NE NW	1.6 AC	
SW NW	0.1 AC	2.1 AC
SE NW	17.9 AC	19.4 AC
NESW		40.0 AC
NW SW		2.7 AC
SW SW		2.2 AC
SE SW		40.0 AC
NW SE		26.3 AC
SW SE *		29.3 AC
SECTION 9		TOTAL 233.9

TOWNSHIP 1 SOUTH, RANGE 45 EAST WM


* AS CRIBBER'S ERROR DESIGNATED THIS AS SE SW ON P-G-13367

COBU MAP #1273B

THIS MAP IS PREPARED FOR WATER RIGHT PURPOSES ONLY AND SHOULD NOT BE USED FOR PROPERTY LOCATION PURPOSES

PERMIT G-13367
PRIMARY & SUPPLEMENTAL 1997
T1S, R45E SEC 4 & 9
WALLONA COUNTY

FINAL PROOF MAP FOR:
OLIVER OR JOANNA WENTZ
68865 ELK MTN RD
ENTERPRISE, OREGON 97828
PREPARED BY RALPH SWINEHART
WALLONA MTN ENGINEERING
JAN 2023

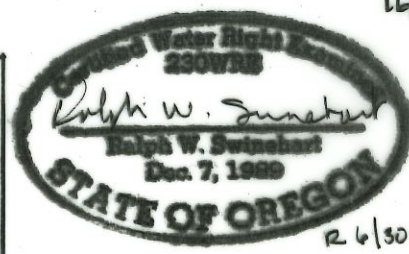

R 6/30/24

COBU MAP #1273B