


CLAIM OF BENEFICIAL USE MAP
 FOR
JOHN + CANDICE DINNIS
 LOCATED IN
JAMES GINGLES D.L.C. NO. 44
W 1/2 SEC. 16, T. 10 S., R. 4 W., W.M.
BENTON COUNTY, OREGON

RECEIVED
 MAY 23 2019
 OWRD

MAY 21, 2019

PERMIT G-16208
 APPLICATION G-16651

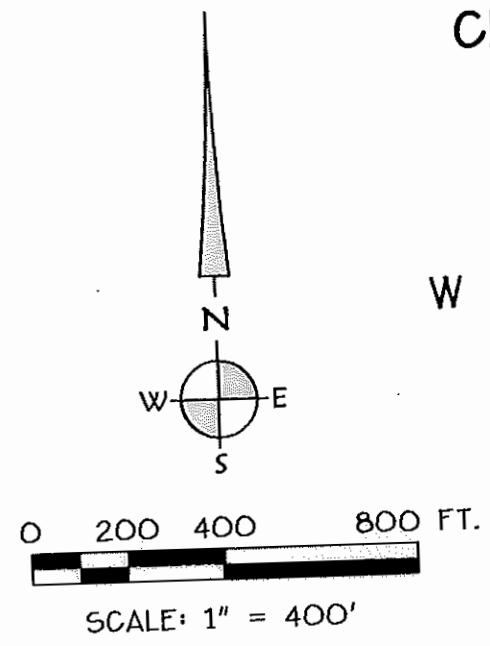


LEGEND:

- POINT OF DIVERSIONS (WELL) LOCATION W/ ATTACHED TOTALIZING FLOW METER
- EXISTING BURIED WATER PIPELINE, SIZE VARIES 1-1/2" + 1-1/4"
- AMOUNT OF ACREAGE IRRIGATED PER QUARTER-QUARTER SECTION IRRIGATED UNDER PERMIT G-16208.
- AREA IRRIGATED UNDER PERMIT G-16208
30.77 ACRES TOTAL.

POINT OF DIVERSION

- WELL #1 - BENT-53201
3080' SOUTH + 1110' EAST FROM THE NORTHWEST CORNER OF SECTION 16.
- WELL #2 - BENT-54621
3170' SOUTH + 1200' EAST FROM THE NORTHWEST CORNER OF SECTION 16.
- WELL #5 - BENT-54622
2790' SOUTH + 1130' EAST FROM THE NORTHWEST CORNER OF SECTION 16.

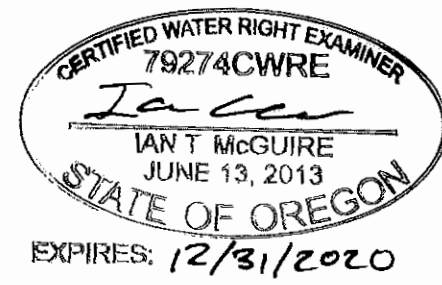

NOTE:

THIS MAP IS NOT INTENDED TO PROVIDE LEGAL DIMENSIONS OR LOCATION OF PROPERTY OWNERSHIP. INFORMATION ON THIS MAP IS COMPILED FROM 2019 BENTON COUNTY GIS DATA, AERIAL PHOTOGRAPHY, AND RECORD WATER RIGHTS INFORMATION.

COBU MAP # 1185