

T. 3N., R. 29E., W.M.


UMATILLA COUNTY

SCALE 1" = 1320'

RECEIVED

SEP 30 1999

WATER RESOURCES DEPT.
SALEM, OREGON

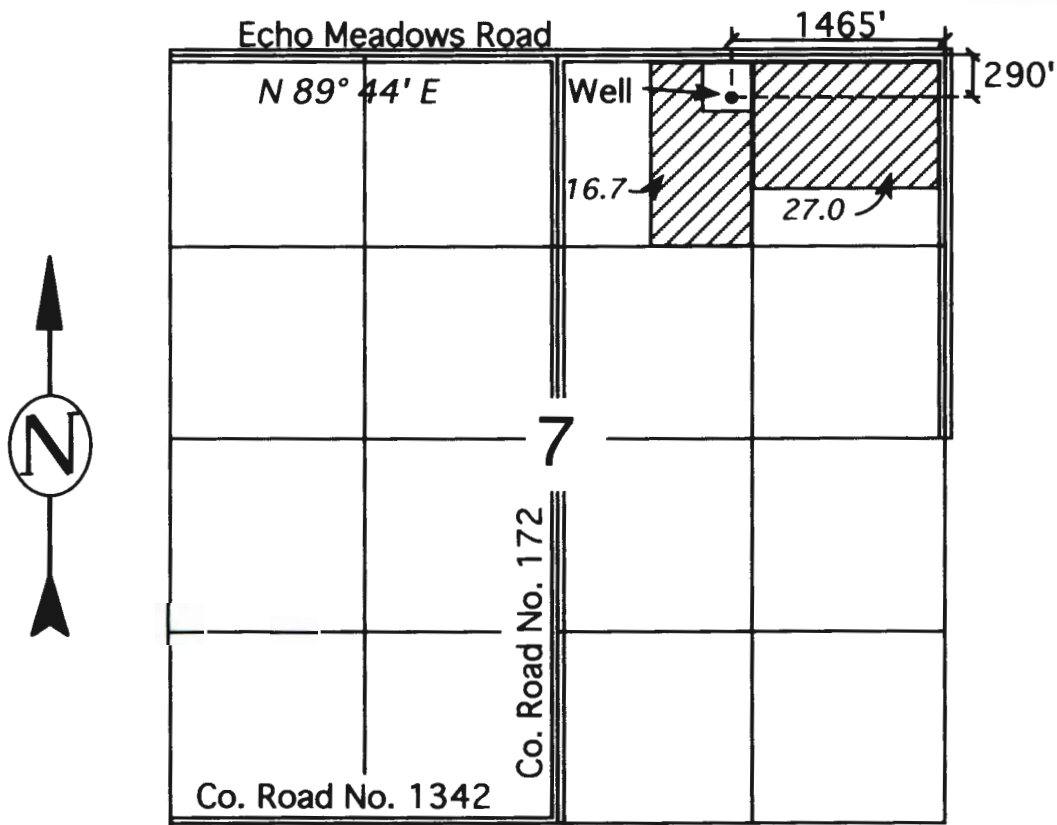

Well Located 290 Ft. South & 1465 Ft. West from the Northeast Corner of Section 7

WATER RIGHTS PROOF MAP

 Supplemental Water Rights Found at This Location

IN NAME OF

Wendell Lampkins

THIS MAP IS FOR THE PURPOSE
OF IDENTIFYING THE LOCATION
OF WATER RIGHTS ONLY AND IS
NOT INTENDED TO PROVIDE THE
LEGAL DIMENSIONS OR LOCATIONS
OF PROPERTY OWNERSHIP LINES.

Ronald V. McKinnis
 Certified Water Right Examiner
 #002 WRI
 RONALD V. MCKINNIS
 NOV. 29, 1988
 STATE OF OREGON
 Exp. 12-31-00

ENGINEERING - LAND SURVEYING - WATER RIGHTS
R. V. MCKINNIS ENGINEERING
 79980 Prindle Loop Road
 Hermiston, Oregon 97838
 (541) -567-2017