


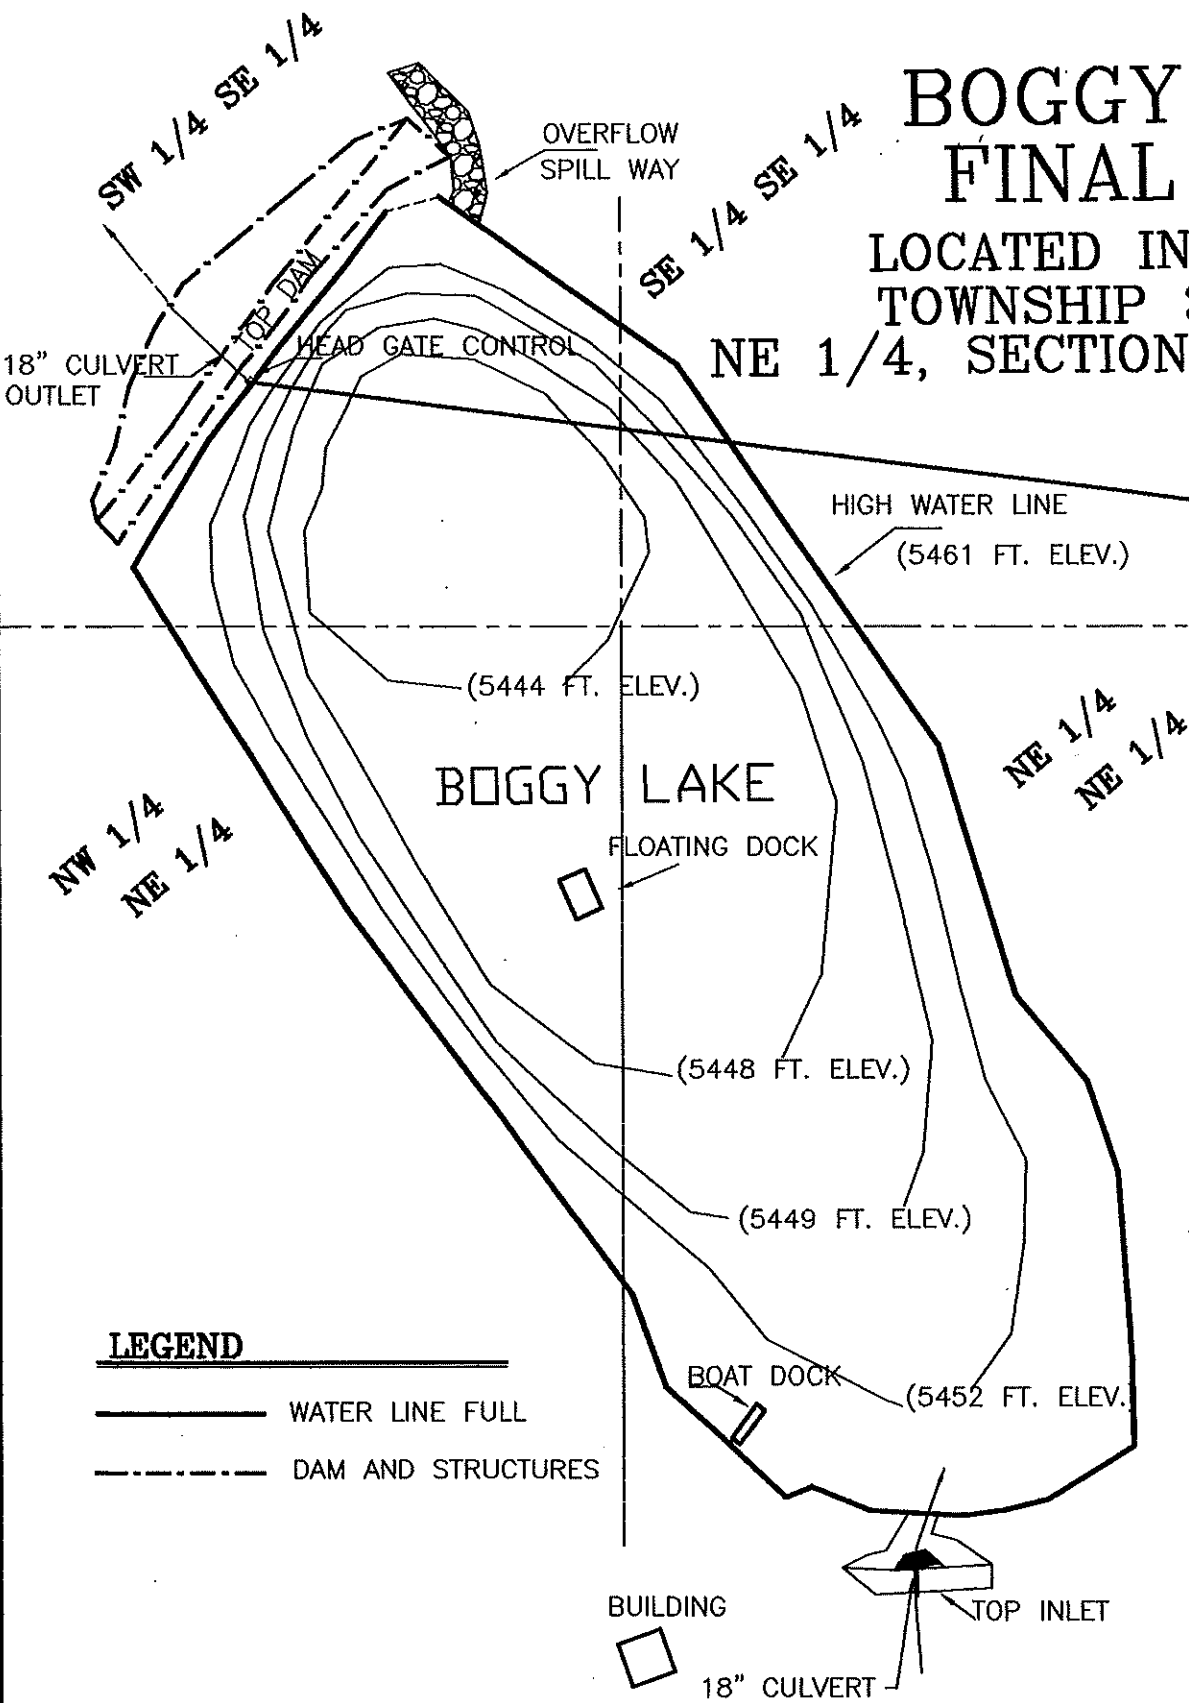

BOGGY LAKE RESEVIOR FINAL PROOF SURVEY

LOCATED IN THE SE 1/4, SECTION 32
TOWNSHIP 36S, RANGE 21E, W.M. AND
NE 1/4, SECTION 5, TOWNSHIP 37S, RANGE 21E, W.M.
LAKE CO. OREGON

APPLICATION NO. R - 83485
PERMIT NO. R - 12541
APPLICATION NO. S - 83486
PERMIT NO. S - 53490

S 84°52'26" E
1535.54 FT

TOWNSHIP 36 SOUTH
TOWNSHIP 37 SOUTH

32 33
5 4

FOUND
GLO BRASS CAP
T36S, SEC. 32,33
T37S, SEC. 5, 4

AREA CAPACITY


ELEVATION FEET	AREA S/F	VOLUME C/F
5444	27672	
5448	89553	234450
5449	126692	108123
5452	162688	434070
5459	206328	1291556
5461	218876	425204
TOTAL VOLUME C/FT		2493403
ACRE FEET		57.2

RECEIVED

SEP 30 2004

WATER RESOURCES DEPT
SALEM OREGON

SCALE: 1"=100'

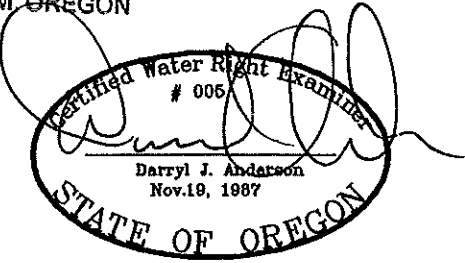

RENEWAL 12/31/05

NOTE: PREPARATION OF THIS MAP IS FOR IDENTIFYING PROPOSED
WATER RIGHTS ONLY. IT HAS NO INTENT TO PROVIDE LOCATIONS
OR DIMENSIONS OF PROPERTY BOUNDRIES..

REVISION	BY


**ANDERSON ENGINEERING
AND SURVEYING, INC.**
P.O. BOX 28
LAKEVIEW, OREGON 97630
(541) 947-4407
FAX 947-2321

**BOGGY LAKE RESEVIOR
FINAL PROOF SURVEY**
BRAD MOMBERT
20469 MAINLINE RD.
BEND, OR. 97702

DATE: SEPT. 2004
SCALE: 1"= 100'
JOB: 2003-83
DWG. BY: LH
FILE: 2003-83
SHEET 1 OF 2

BOGGY LAKE RESEVIOR FINAL PROOF SURVEY


LOCATED IN THE SE 1/4, SECTION 32
TOWNSHIP 36S, RANGE 21E, W.M. AND
NE 1/4, SECTION 5, TOWNSHIP 37S, RANGE 21E, W.M.
LAKE CO. OREGON

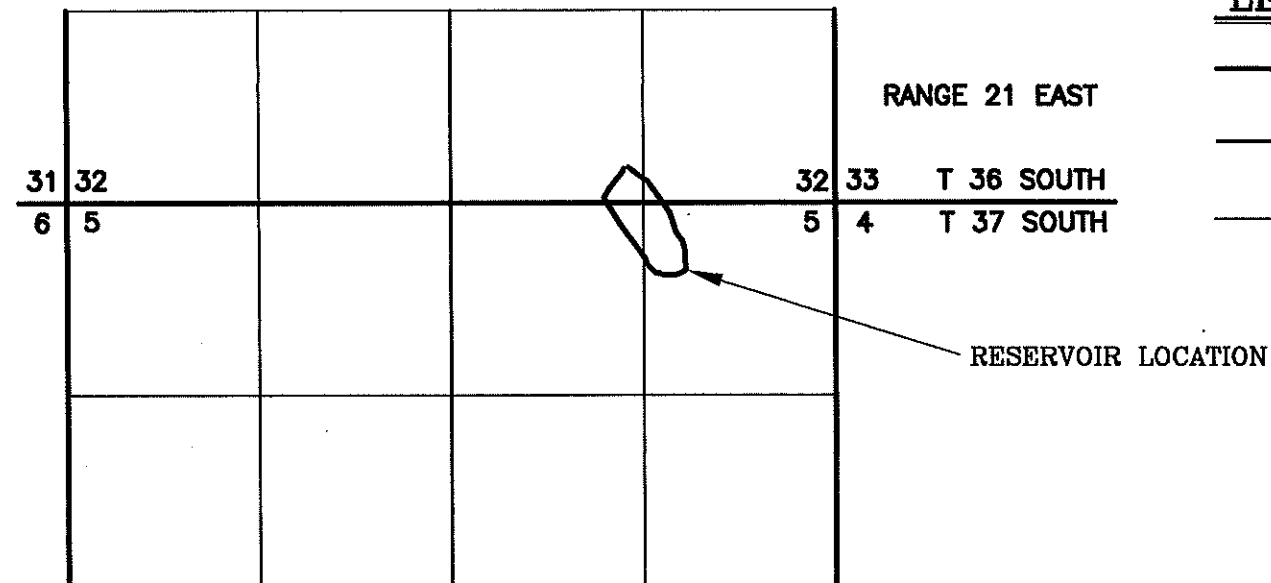

LEGEND

- SECTION LINE
- 1/4 SECTION LINE
- 1/16 SECTION LINE

SEE SECOND SHEET
FOR DAM & RESERVOIR DETAILS

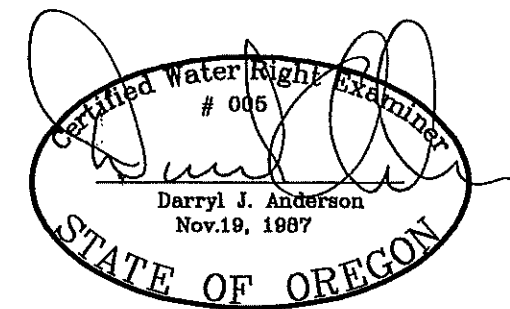

RENEWAL 12/31/05

RECEIVED

SEP 30 2004

WATER RESOURCES DEPT
SALEM, OREGON

SCALE: 1"=1320'

NOTE: PREPARATION OF THIS MAP IS FOR IDENTIFYING PROPOSED
WATER RIGHTS ONLY. IT HAS NO INTENT TO PROVIDE LOCATIONS
OR DIMENSIONS OF PROPERTY BOUNDRIES..

APPLICATION NO. R - 83465
PERMIT NO. R - 12541
APPLICATION NO. S - 83466
PERMIT NO. S - 53490

PREPARED FOR:
BRAD MOMBERT
20489 MAINLINE RD.
BEND, OR. 97702
(541) 617-1851

PREPARED BY:
ANDERSON ENGINEERING & SURVEYING, INC.
P.O. BOX 28 P.O. BOX 419
LAKEVIEW, OREGON 97630 REDMOND, OREGON 97756
(541) 947-4407 (541) 923-4307
FAX 947-2321 FAX 923-4308

DATE: SEPT 2004

DWG. FILE: 2003-63

JOB NO.: 2003-63

SHEET 2 OF 2