



CLAIM OF BENEFICIAL USE MAP

APPLICATION# S-84230
 PERMIT# S-53701
 SECTION 3, TOWNSHIP 40
 SOUTH, RANGE 14 WEST, W.M.
 CURRY COUNTY, OREGON

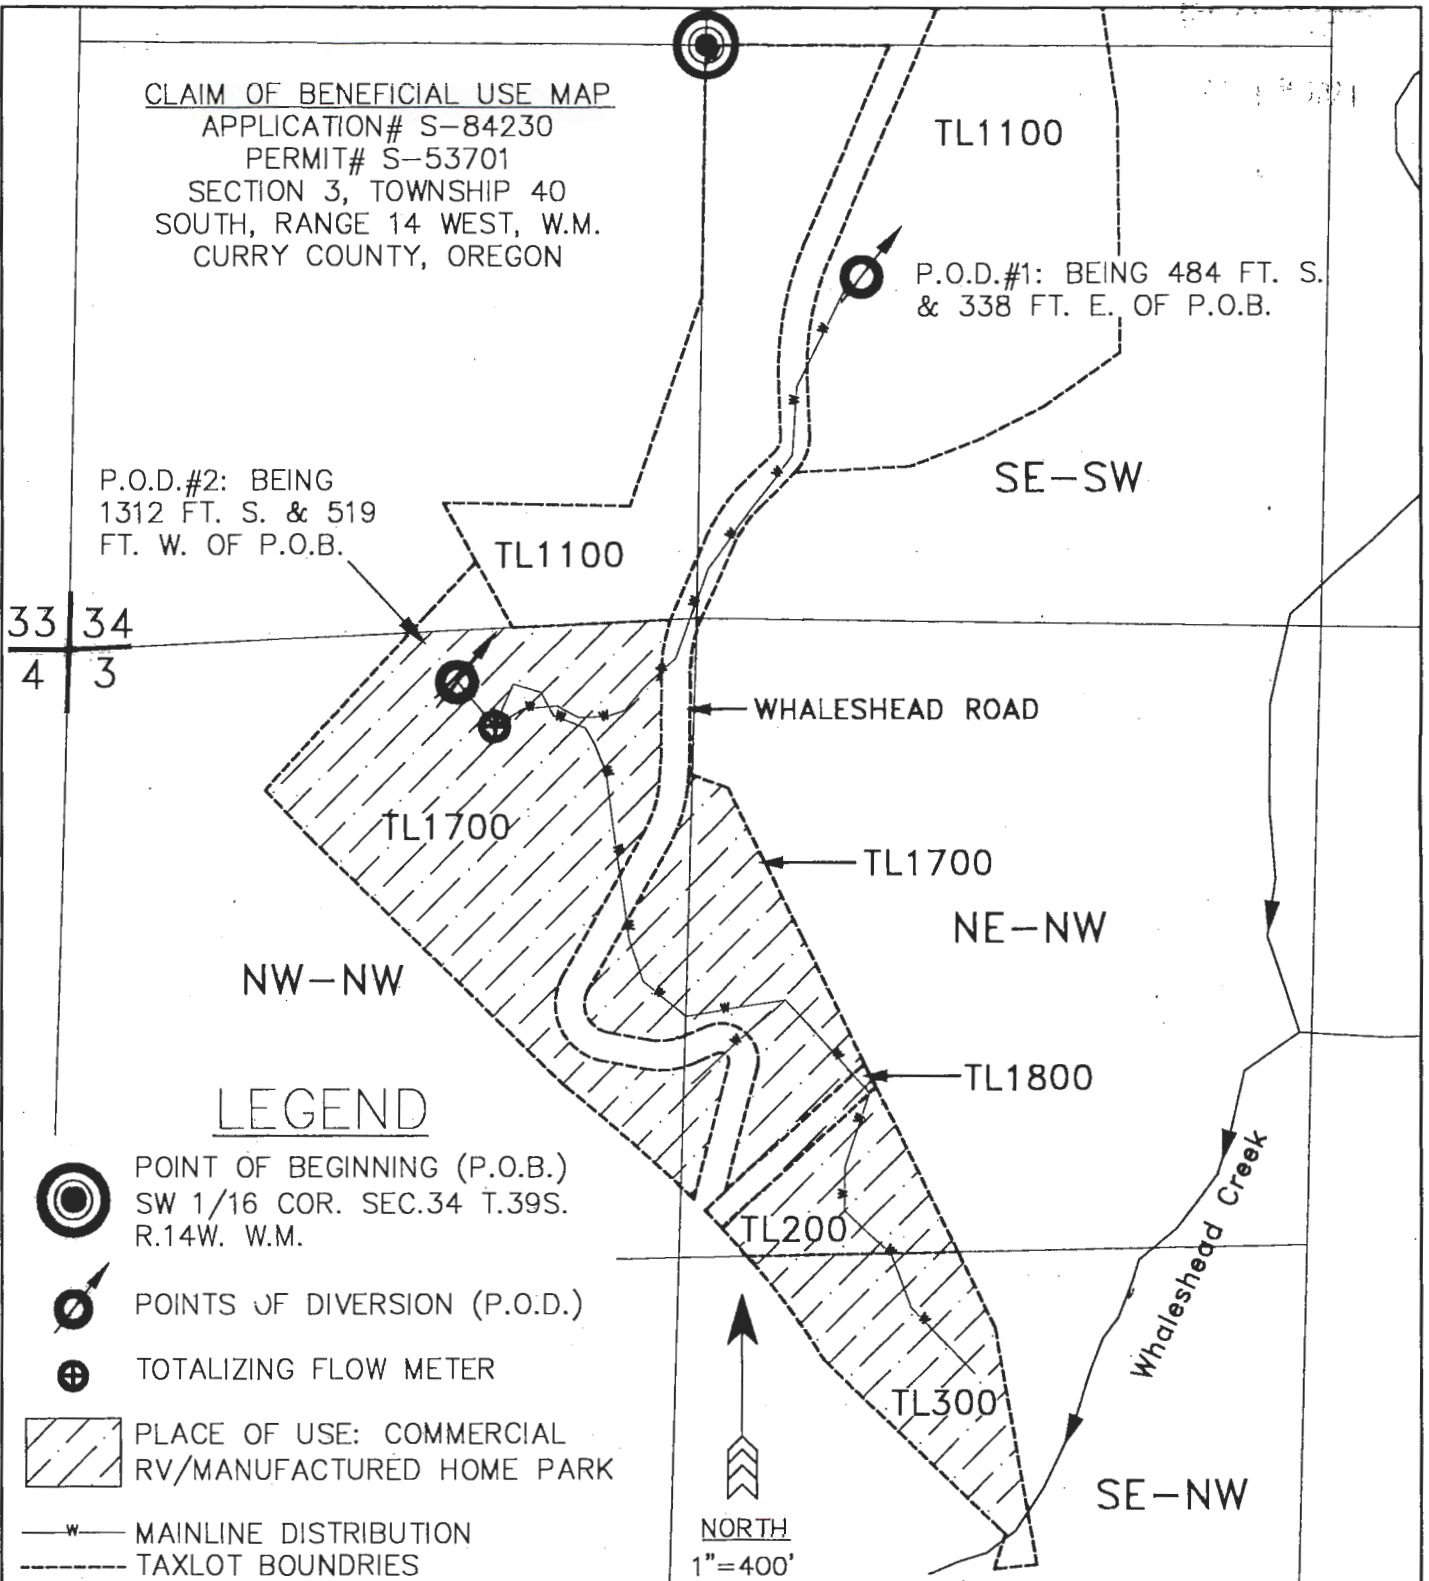

DISCLAIMER: THIS MAP
 WAS PREPARED FOR
 THE PURPOSE OF
 IDENTIFYING THE
 LOCATION OF WATER
 RIGHT ONLY AND IS
 NOT INTENDED TO
 PROVIDE LEGAL
 DESCRIPTIONS OR
 LOCATIONS OF
 PROPERTY LINES.

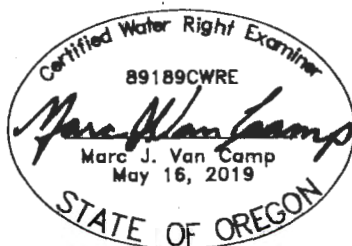

EXPIRES 06/30/2022



P.O. Box 995
 Coos Bay, OR 97420
 (541) 297-1880
 vancampconsulting@gmail.com

Prepared For:
 Whaleshead Beach
 Resort
 19921 Whaleshead Rd.
 Brookings, OR 97415

Project:
 Permit# S-53701
 Claim of Beneficial
 Use Map

Date: 07/15/2020