


T6S R1E, WM

CLACKAMAS COUNTY

TAX LOT:
6S 1E 8 400

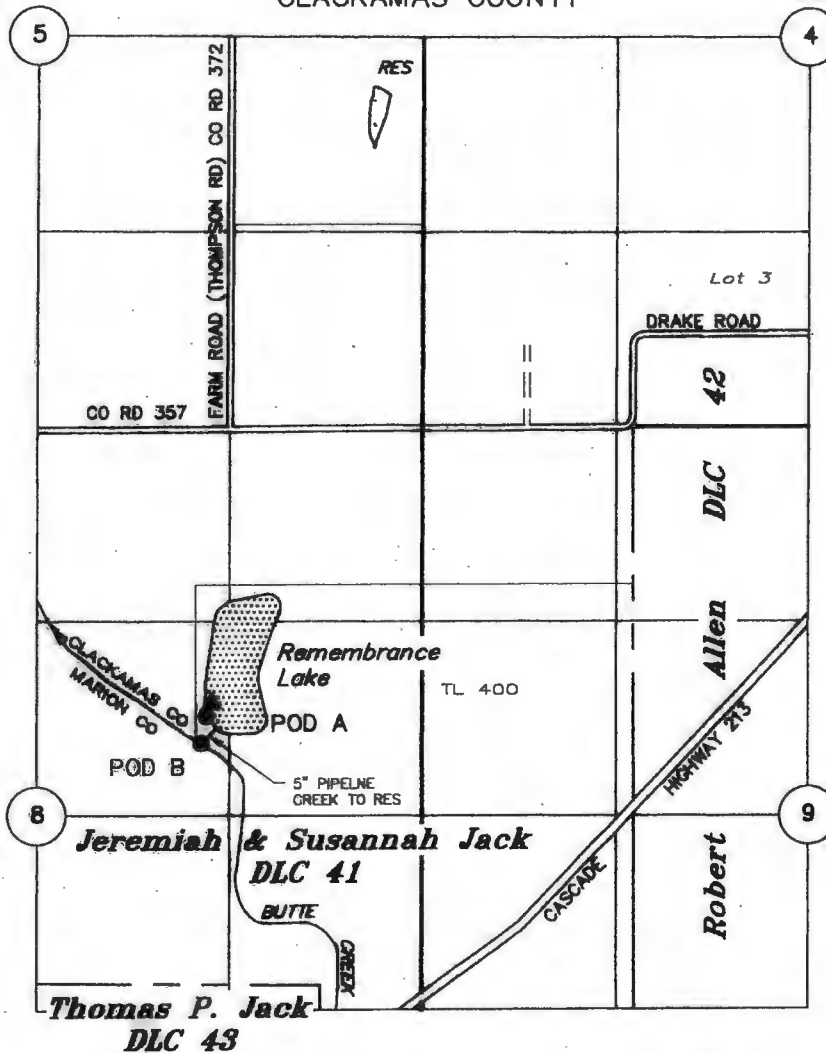

- POD A DAM: 1950' S & 1482' W OF NE COR SEC 8 ●
- STAFF GAGE: 1862' S & 1443' W OF NE COR SEC 8 ▲
- POD B BUTTE CREEK INTAKE: 2077' S & 1575' W OF NE COR SEC 8 ●
- POD B BUTTE CREEK SCREEN: 2070' S & 1582' W OF NE COR SEC 8 ●
- POD B BUTTE CREEK METER: 1984' S & 1460' W OF NE COR SEC 8 ●

CLAIM OF BENEFICIAL USE

UNDER


Application No. R-87276 Permit No. R-14820

IN THE NAME OF

VICTOR SCHNEIDER, Jr.

September 24, 2010 & August 23, 2018

SCALE: 1" = 1320'

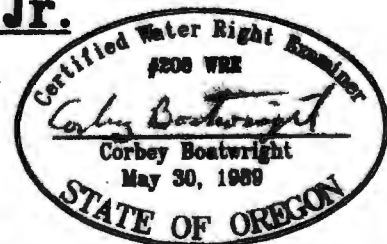

NOTE: This map is not intended to provide legal dimensions or locations of property ownership lines.

RENEWAL DATE: DECEMBER 31, 2021