


T6S R1E, WM

CLACKAMAS COUNTY

TAX LOT:

- 6S 1E 4 900
- 6S 1E 4 1000
- 6S 1E 5 1900
- 6S 1E 5 2000
- 6S 1E 8 101
- 6S 1E 8 400

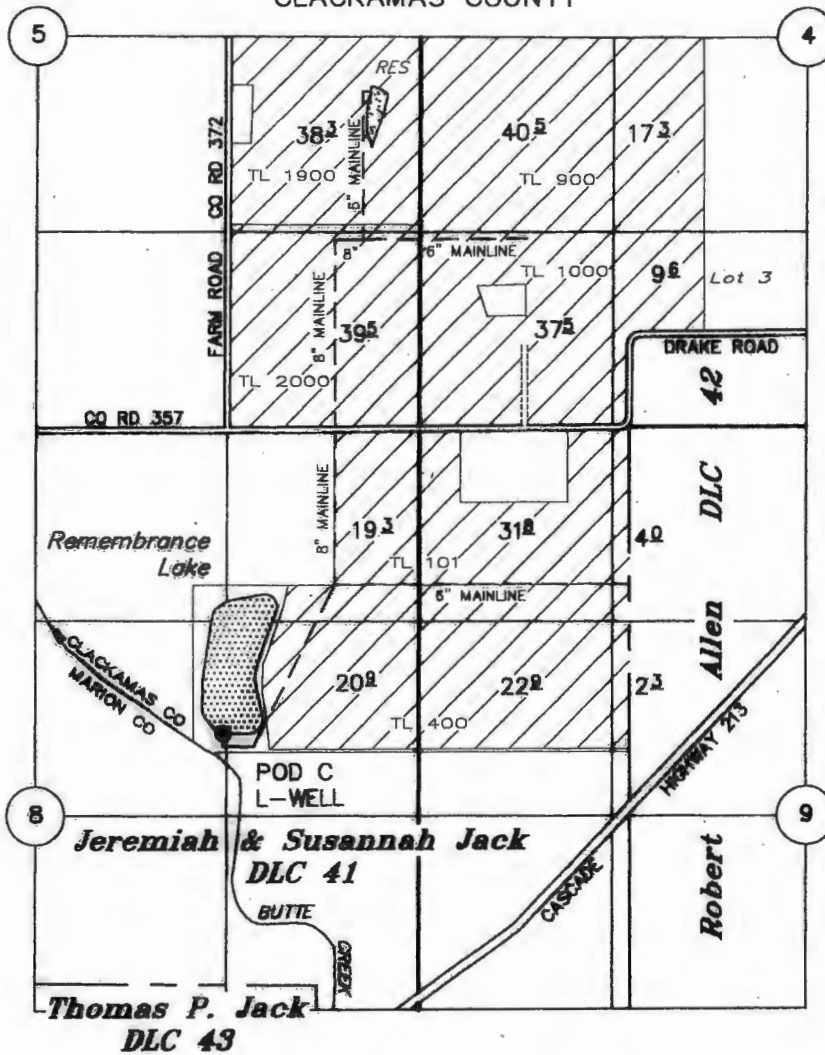

 SUPPLEMENTAL



POD C, L-WELL: 1975' S & 1472' W OF NE COR SEC 8
 METER: 1985' S & 1460' W OF NE COR SEC 8

CLAIM OF BENEFICIAL USE

UNDER

Application No. S-87277 Permit No. S-54626

IN THE NAME OF

VICTOR SCHNEIDER, Jr.

September 24, 2010
 SCALE: 1" = 1320'



NOTE: This map is not intended to provide legal dimensions or locations of property ownership lines.

RENEWAL DATE: DECEMBER 31, 2021