
1/31/2023- Frederick F. Walker and Patricia T. Walker, Trustees of the Frederick F. and Patricia T. Walker Living Trust dated September 25, 2018

Map for Part Cancellation of Certificate 80689 with Priority Date December 28,1978.

Cancel 5.0 acre T15S R14E S14, NENE, Primary Irrigation

Township 15 South Range 14 East, NE 1/4 Section 14

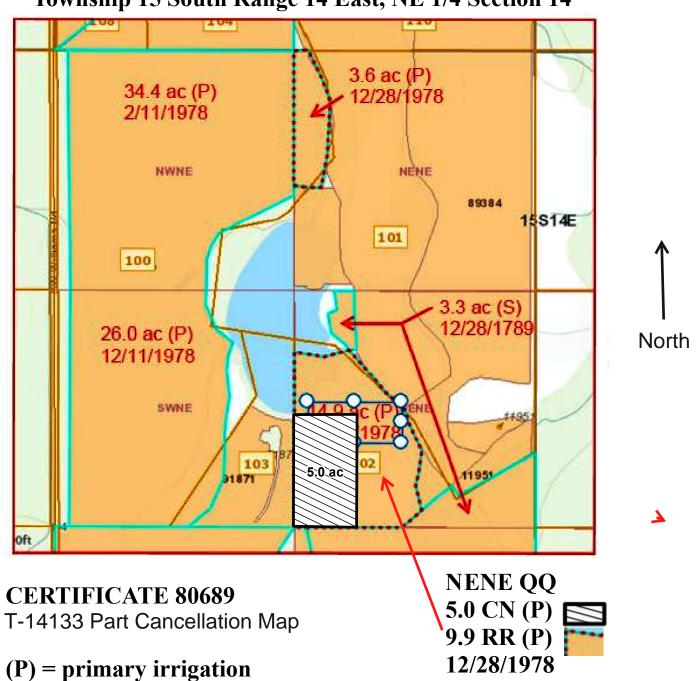

(S) = supplemental irrigation