



# T.4S. R.1E. Section 31, W.M.

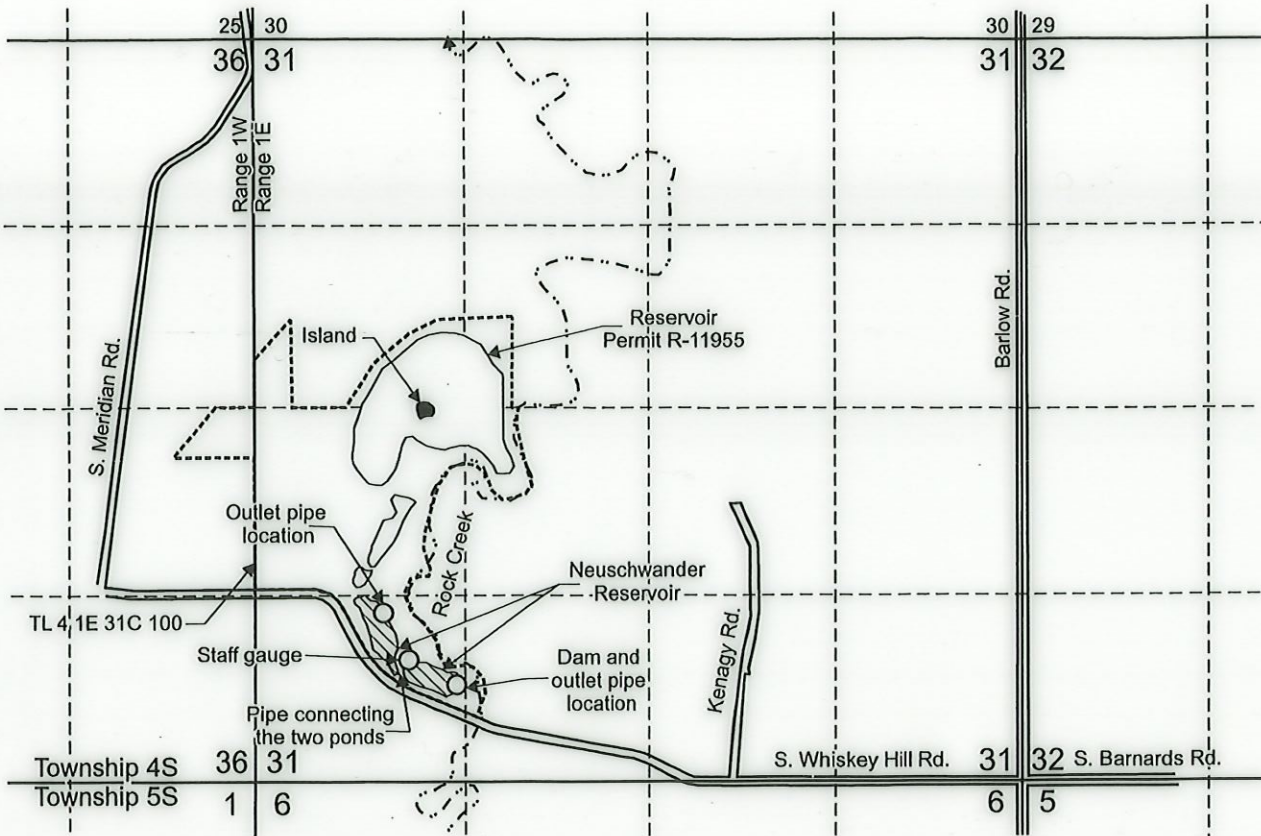

Neuschwander Reservoir is located in the SWSW, Section 31, T.4S., R.1E. W.M.

Dam is located 690 feet north and 1,415 feet east from the SW corner, Section 31.

 Area (3.1 Acres) submerged at full stage by Neuschwander Reservoir authorized under Application R-85252, Permit R-13572.

----- Tax lot boundary

RECEIVED

APR 03 2023

OWRD

Scale: 1" = 1,320'



This map was prepared for the purpose of identifying the location of a water right only and is not intended to provide legal dimensions or location of property ownership lines.

Claim of Beneficial Use Map  
Application R-85252, Permit R-13572

Pacific Hydro-Geology Inc.

07/2021  
Rev3. 03/2023

Raymon Neuschwander  
T.4S. R.1E. Section 31, W.M.