


LEGEND

- ⊙ HOSE BIB 3/4"
- ⚡ 40 GALLON PRESS TANK
- ▨ NURSERY AREA
- ⌵ Quarter Corner
- POD#1
- Rebar

FINAL PROOF CLAIM OF BENEFICIAL USE MAP
FOR
BRYAN & CASSANDRA BARRETT
LOCATED IN THE
NE 1/4 OF THE NW 1/4 OF SECTION 33
TOWNSHIP 19 SOUTH, RANGE 1 WEST, W.M.
LANE COUNTY, OREGON
MAY 16, 2018
REVISED DECEMBER 7, 2022

APP. # G-16115, PERMIT # G-15784

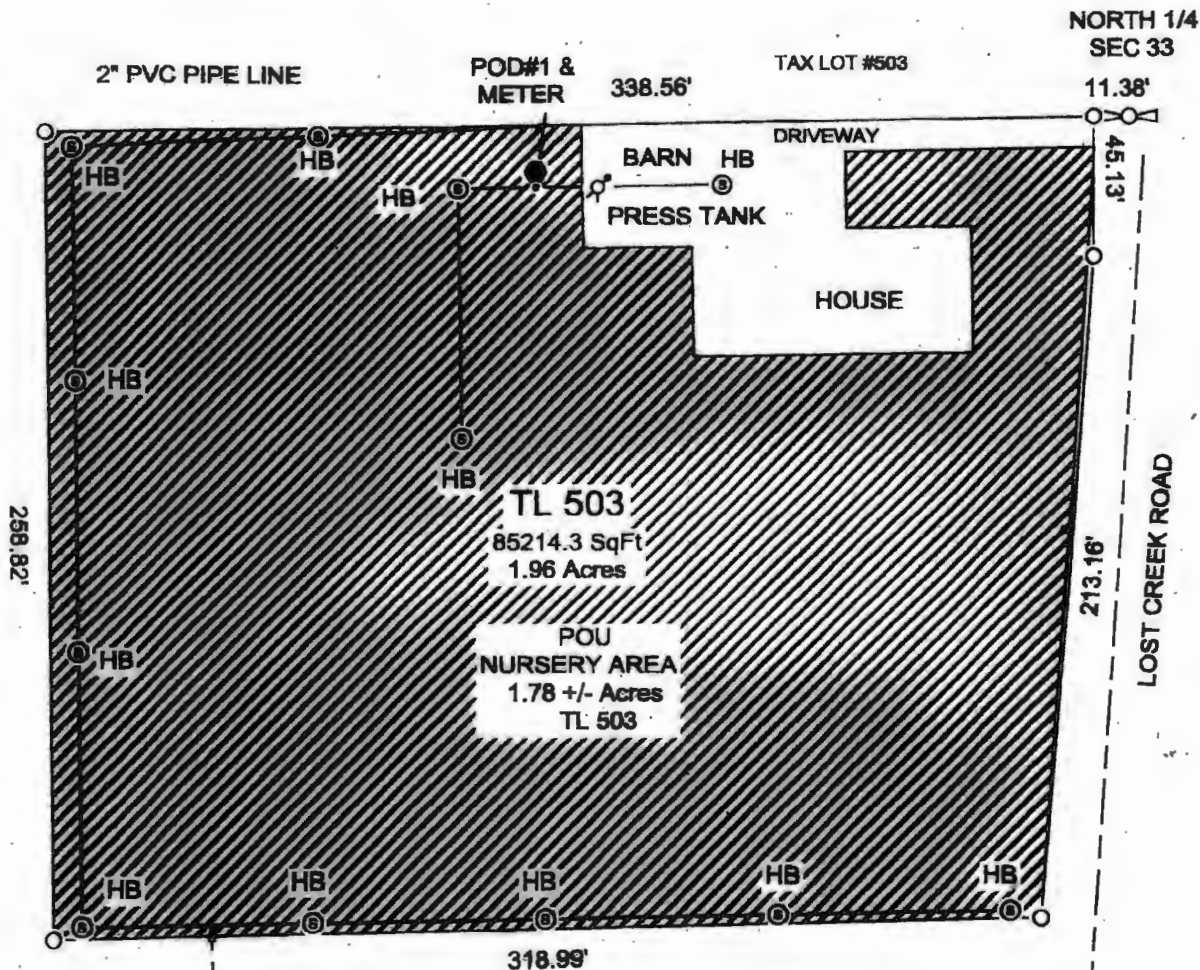


2" PVC



POD #1 LOCATED
18' SOUTH, 191' WEST
OF N 1/4 SEC 33.

DISCLAIMER: THIS MAP IS NOT INTENDED TO
PROVIDE LEGAL DIMENSIONS OR LOCATIONS
OF PROPERTY OWNERSHIP LINES.

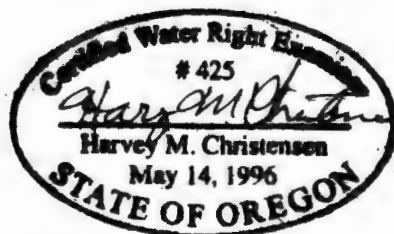

RECEIVED
DEC 15 2022
OWRD