

Claim of Beneficial Use

Permit G-18536, Application G-18778

A Water Right held by Ste Michelle Wine Estates
Yamhill County

RECEIVED

AUG 31 2022

OWRD




C:\OneDrive\Geo-Logic Associates, Inc\SWR - Files\Project\Ste Michelle\0_GIS\1_SWR_Files\1_SWR_Maps\Ste_Michelle.ggz

LEGEND

- Point of Appropriation (POA)
- Place of Use (POU)
- Property Lines
- Section
- Quarter-Quarter
- Donation Land Claims
- Streams

POA Location Description

Well 2 (YAMH-58090, L-131340)
Located 603 feet South and 550 feet East from the NW corner,
SWSW, Section 22, Township 3S, Range 3W, W.M.

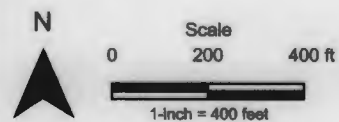

Date: 6/10/2022
Data Sources: BLM, ESRI, OWRD, USGS, Yamhill Co.
Disclaimer: This map was prepared for the purpose of identifying
the location of a water right only and is not intended to provide
legal dimensions or location of property ownership lines.



RENEWS: 12-31-2022

CWRE Seal and Signature

