


T14S R17E, WM, CROOK COUNTY, OR

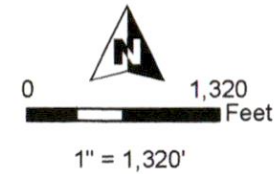

- ⊙ POD
- Bulge-in-System
- Ochoco Reservoir
- Creek
- Pipeline
- C-89615 (1880 Priority) POU IR "OFF"
- C-89615 (1880 Priority) POU IR "UNCHANGED"
- C-89615 (1880 Priority) POU IR "ON"
- Section
- Quarter Quarter
- Tax Lot

RECEIVED


APR 26 2021

OWRD

POD Location:
2018' S, 2605' E of SW Cor Sec 26



RENEWAL DATE 12/31/2022

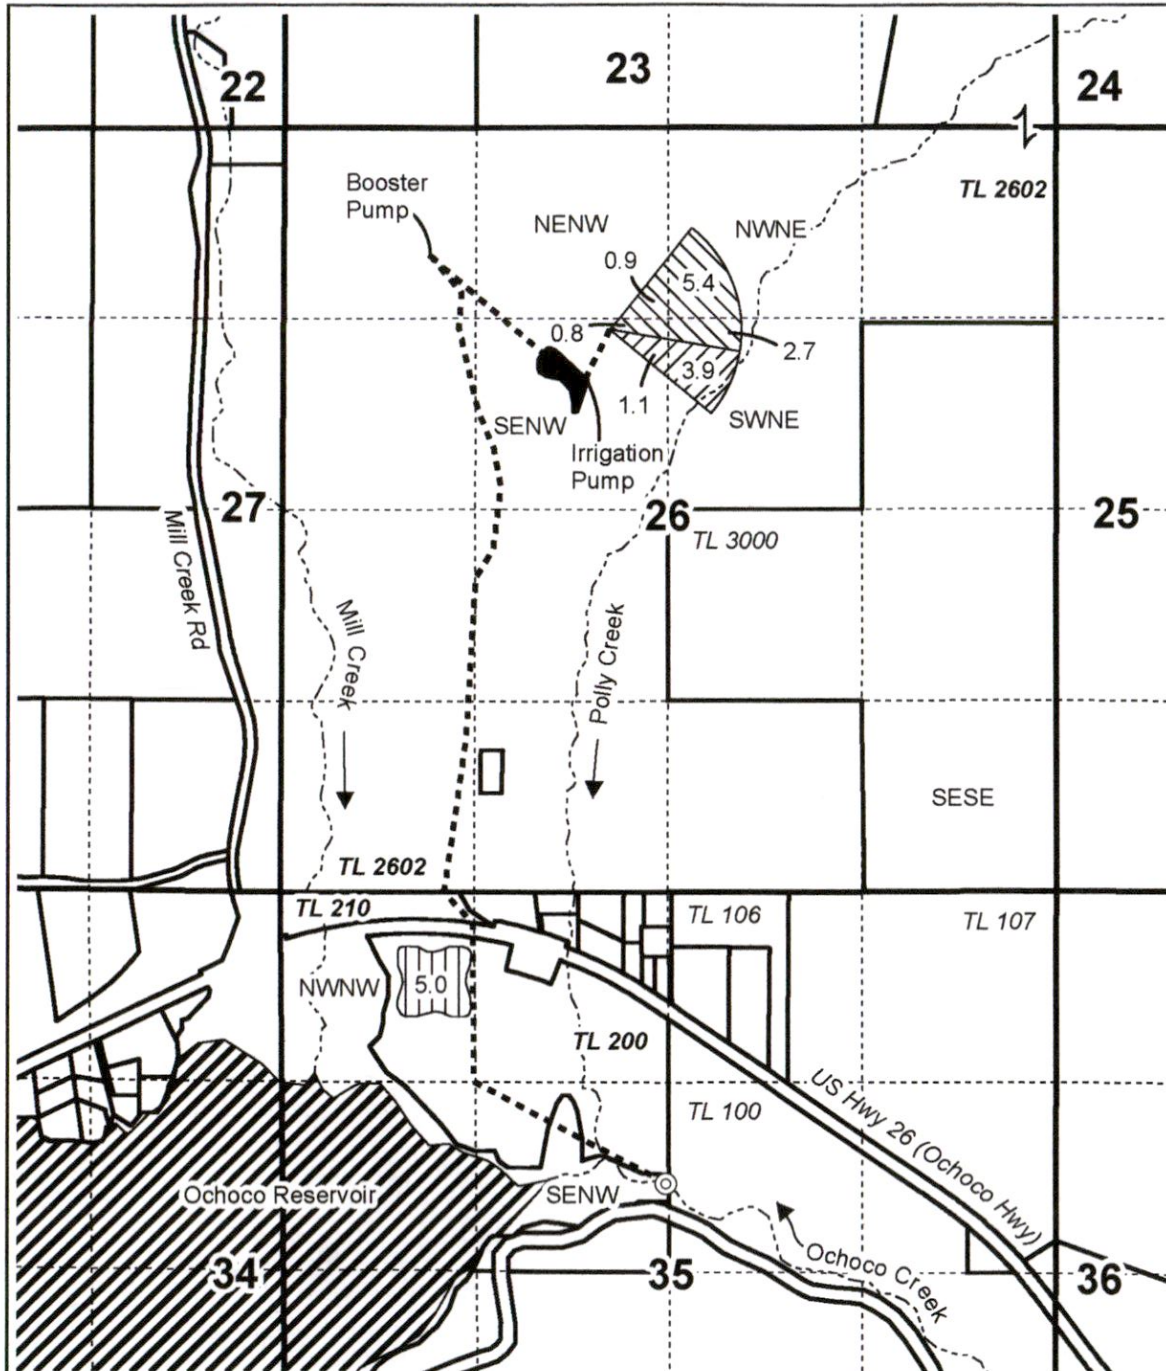

PERMANENT TRANSFER MAP Dice Ranch

Date: 1/21/2021

C-89615

This map is not intended
to provide legal dimensions
or locations of property
ownership lines.

WATER RIGHT SERVICES, LLC
PO BOX 1830, BEND, OR 97709
WWW.OREGONWATER.US CCB # 197121
johnshort@usa.com 541-389-2837

0 660 1,320 2,640 3,960 5,280 Feet

1" = 1320'




T 14 S, R 17 E, WM

CROOK COUNTY, OREGON

RECEIVED BY OWRD

JUN 20 2014


SALEM, OR

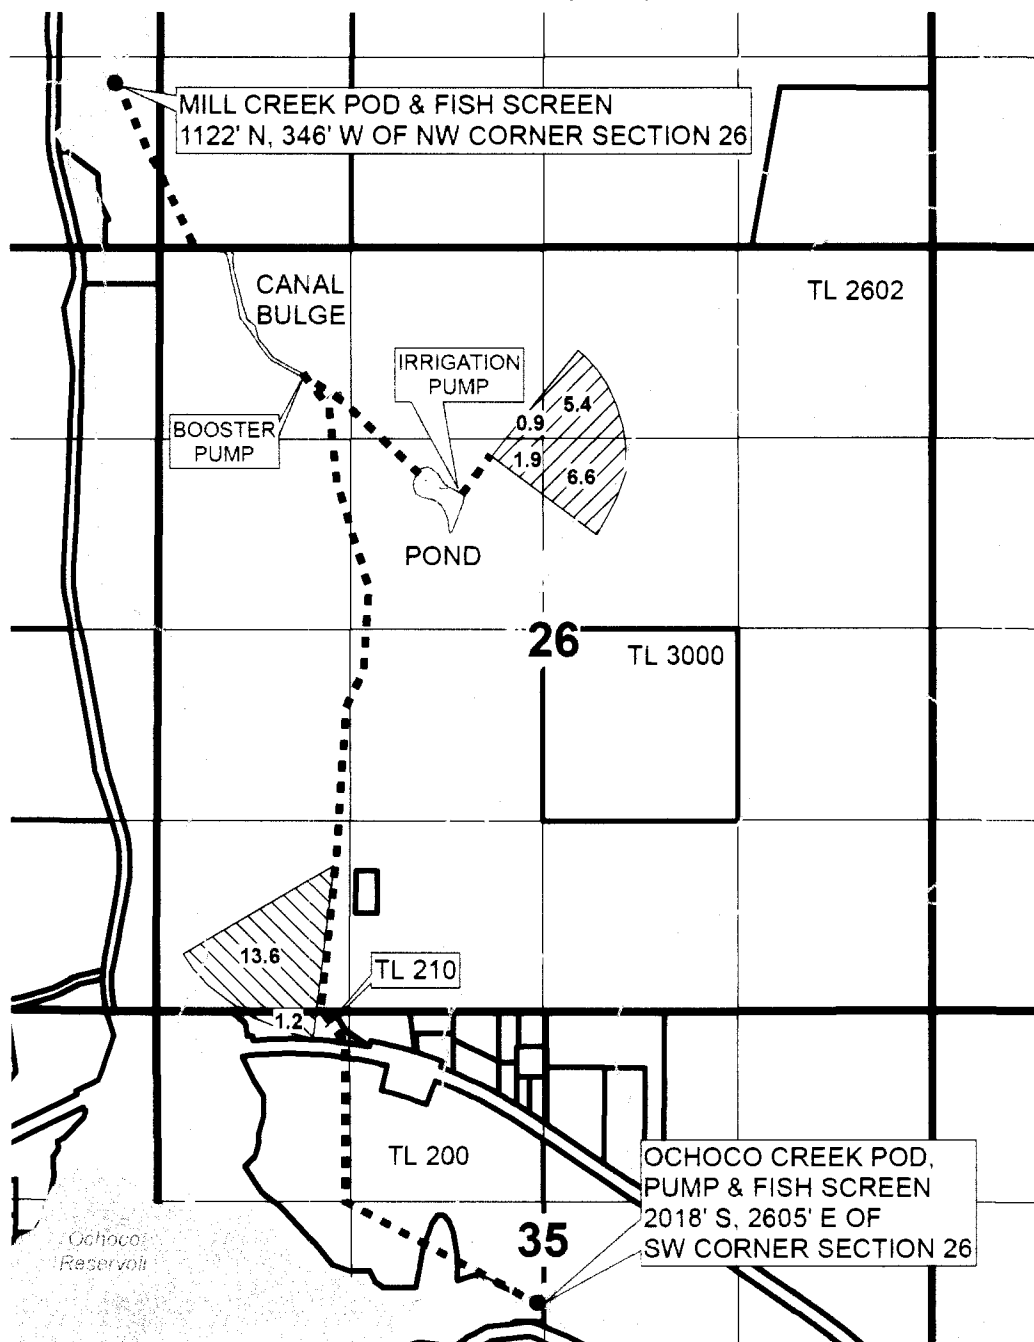

--- BURIED PIPELINES

 1868 MILL CREEK POU BY QQ (FROM 83657)

 1880 OCHOCO CREEK POU BY QQ (FROM 83658)

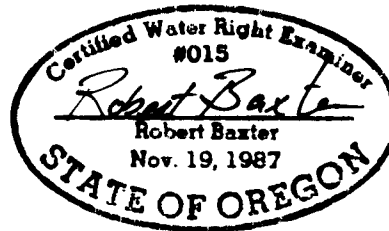

RENEWAL DATE: 12-31-2015



**CLAIM OF BENEFICIAL USE MAP
FOR MILL CREEK LAND, LLC**

TRANSFER T-11465 APR 2, 2014

This map is not intended
to provide legal dimensions
or locations of property
ownership lines.

JOB # 2012021

WATER RIGHT SERVICES, LLC

PO BOX 1830, BEND, OR 97709

WWW.OREGONWATER.US 541-389-2837

CCB # 197121

johnshort@usa.com