


T.3S. R.5W. Section 16, W.M.

RECEIVED

OCT 11 2022

OWRD

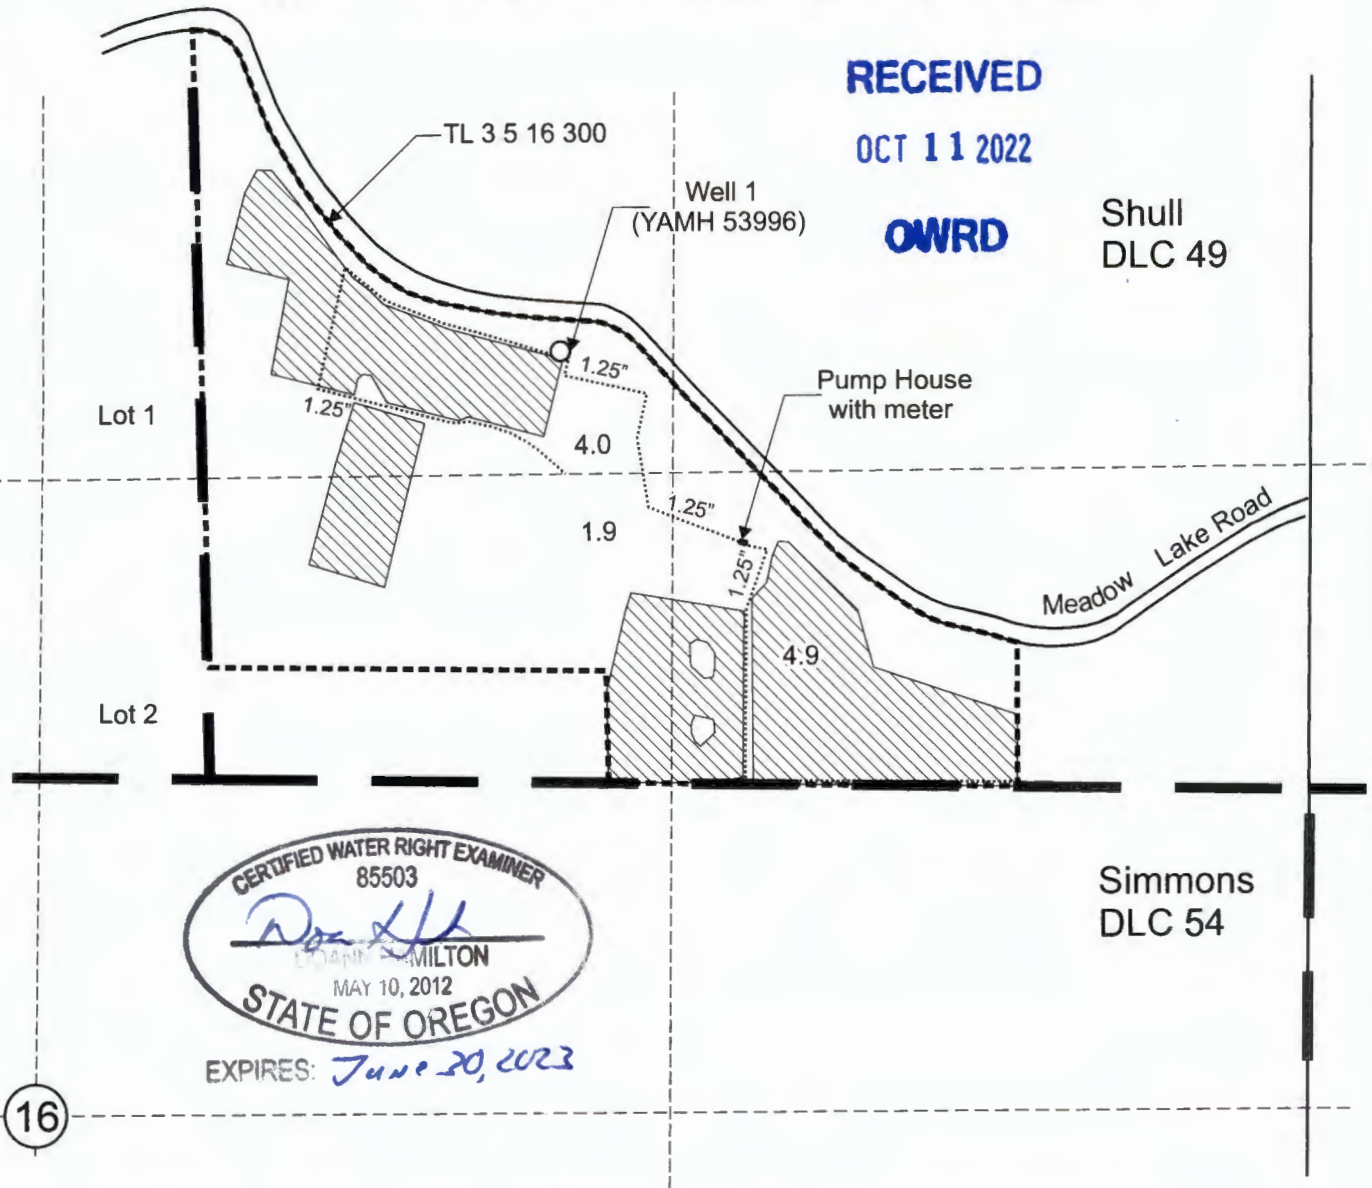


Shull
DLC 49




Simmons
DLC 54

Well 1 (YAMH 53996) is located 1,575 feet north and 1,095 feet east from the center 1/4 corner, Section 16.

 Area (10.8 acres) irrigated under Application G-18534, Permit G-18005.

-  Tax lot boundary
-  Donation Land Claim boundary
-  Water main line

Scale: 1" = 400'

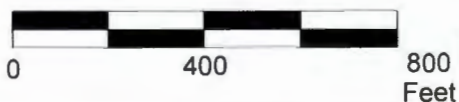

This map was prepared for the purpose of identifying the location of a water right only and is not intended to provide legal dimensions or location of property ownership lines.



Claim of Beneficial Use Map
Application G-18534, Permit G-18005

Pacific Hydro-Geology Inc.

Lonesome Rock Vineyards LLC
T.3S. R.5W. Section 16. W.M.

10/2022