


Existing New POD for Lands irrigated South of the Grande Ronde River is S 2561' and W 825.2' from N 1/4 corner of Section 32, T 2 S Range 39 E, WM.

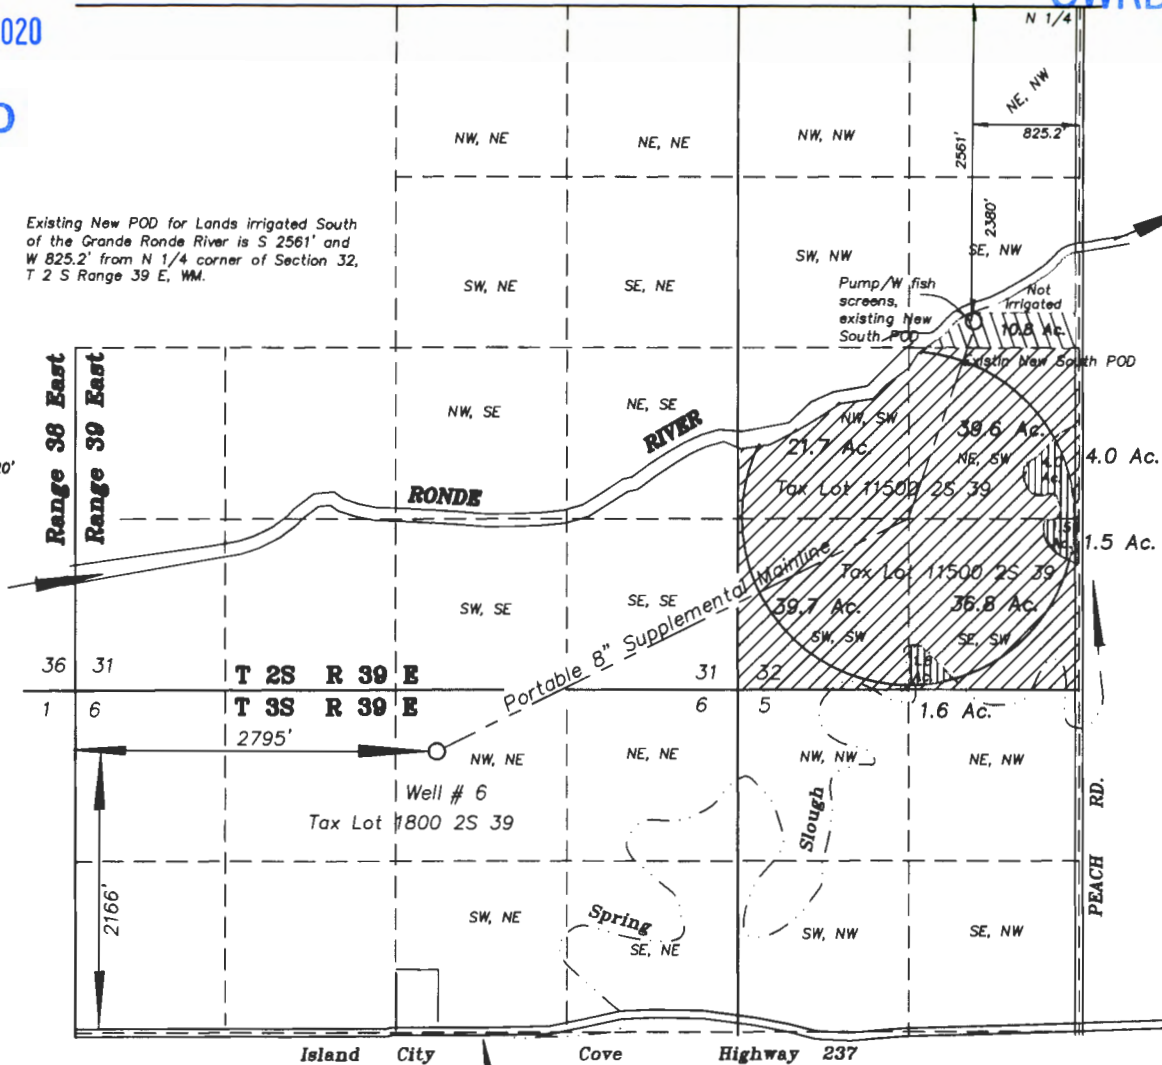


Lands with primary water from Grande Ronde River under C-41055 and supplementary water from Well #6 under C-91415 remaining in place.



Lands under C-91415 and C-41055 remaining in place with new POD from New Pump South POD location. 10.8 Ac.



Lands located in new place of use and having a new POD from the New South POD as directed under T-12591. 7.1 Ac.

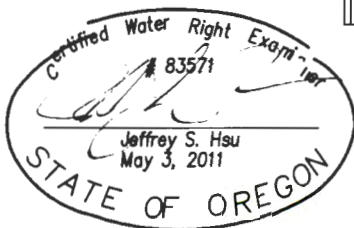

Renews: June 30, 2021

NOTE: The preparation of this map was for the purpose of identifying the location of the proposed water right and has no intent to provide dimensions or location of property ownership lines. Location information shown hereon was furnished by the applicant.

May 13, 2020

**CLAIM OF BENEFICIAL USE MAP FOR LANDS IRRIGATED UNDER TRANSFER T-12591 FOR CHANGE OF PLACE OF USE CHANGE OF POD**

FOR  
MDB FARMS LLC  
Steven A. Delashmutt, manager  
BY

BAGETT-GRIFFITH & BLACKMAN,  
2006 ADAMS AVENUE  
LA GRANDE, OREGON 97850

APPLICATION NO. \_\_\_\_\_  
PERMIT NUMBER T-12591