RECEIVED
AUG 20 2020
OWRD

RECEIVED
JUL 30 2020
OWRD

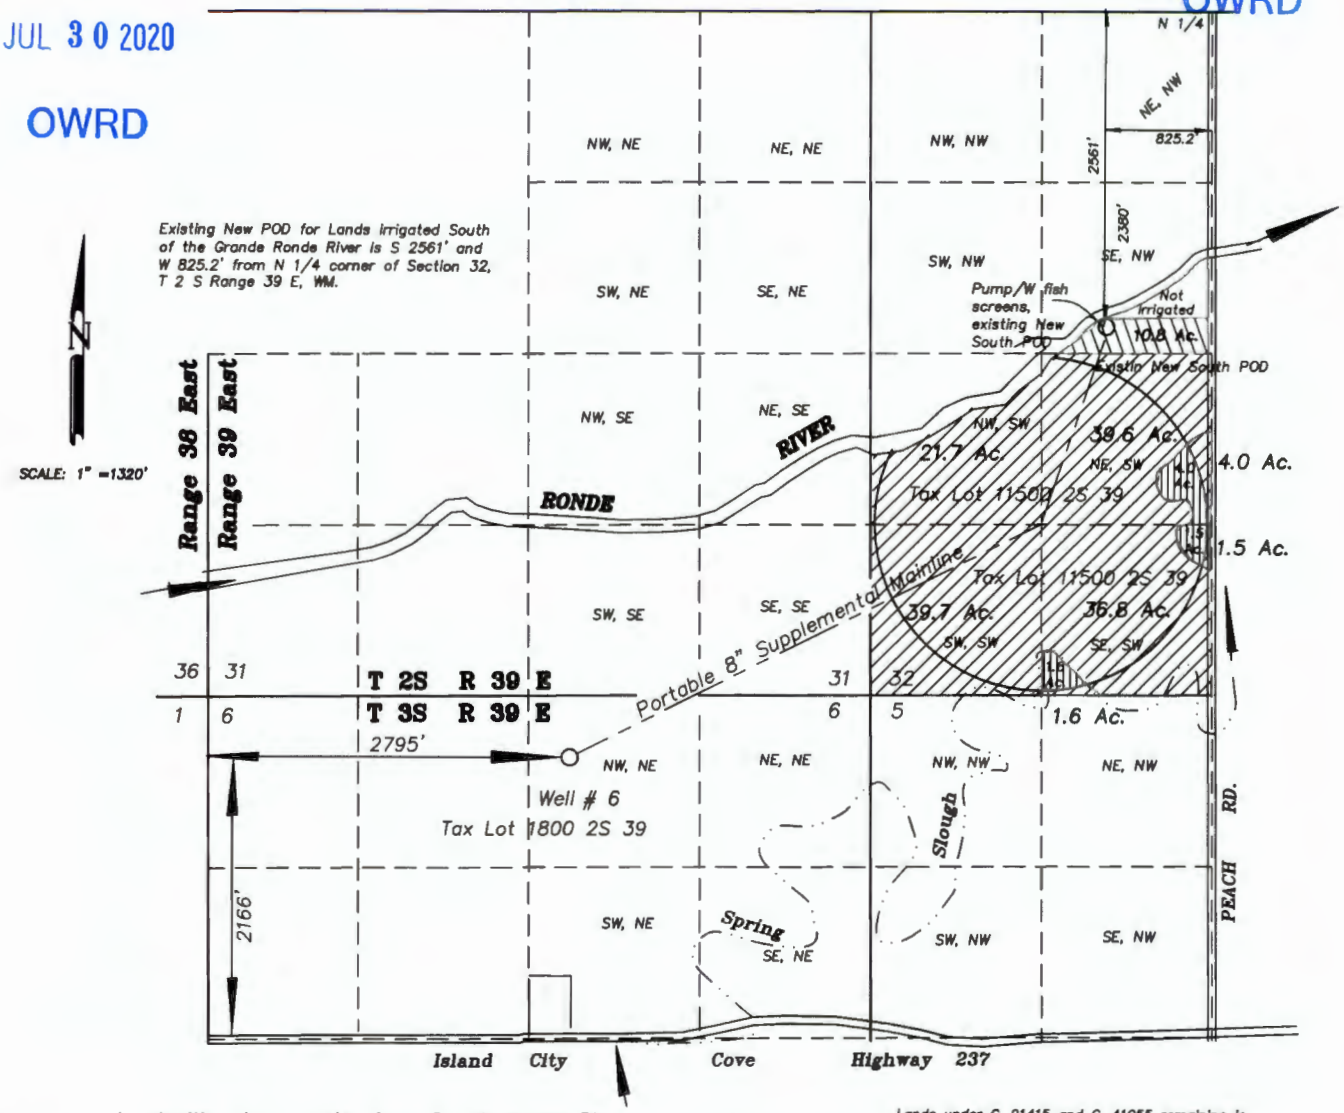

Landswith primary water from Grande Ronde River under C-41055 and supplementary water from Well #6 under C-91415 remaining in place.

Lands under C-91415 and C-41055 remaining in place with new POD from New Pump South POD location. 10.8 Ac.

Lands located in new place of use and having a new POD from the New South POD as directed under T-12591. 7.1 Ac.

Certified Water Right Examiner
83571
Jeffrey S. Hsu
May 3, 2011
STATE OF OREGON

Renews: June 30, 2021

NOTE: The preparation of this map was for the purpose of identifying the location of the proposed water right and has no intent to provide dimensions or location of property ownership lines. Location information shown hereon was furnished by the applicant.

May 13, 2020

CLAIM OF BENEFICIAL USE MAP FOR LANDS IRRIGATED UNDER TRANSFER T-12591 FOR CHANGE OF PLACE OF USE CHANGE OF POD

FOR
MDB FARMS LLC
Steven A. Delashmutt, manager
BY
BAGETT-GRIFFITH & BLACKMAN,
2006 ADAMS AVENUE
LA GRANDE, OREGON 97850

APPLICATION NO. _____

PERMIT NUMBER T-12591