


Claim of Beneficial Use Application
 App. G-14234, Permit G-13131
 T3S, R1W, Sections 25 and 36, W.M.

Certified Water Rights Examiner
 #71101
 Robert E. Long Jr.
 May 15, 2002
 STATE OF OREGON
 EXPIRES 12-31-20

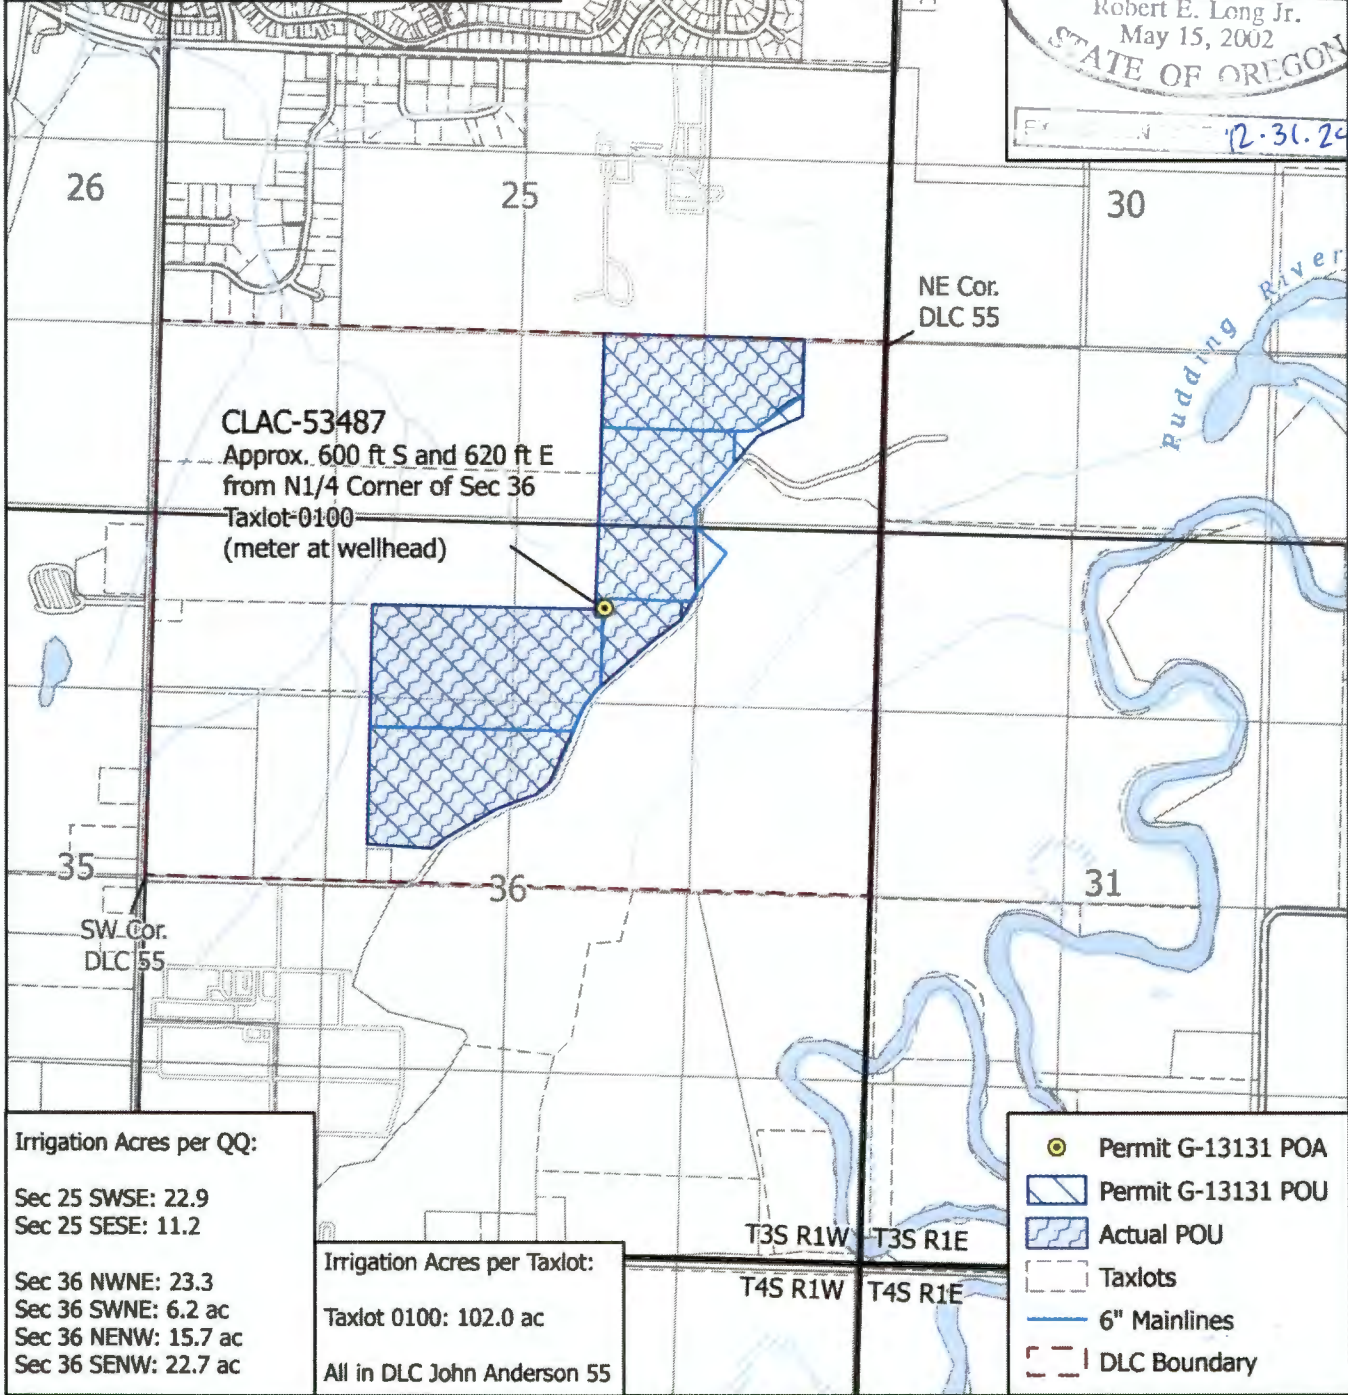

Irrigation Acres per QQ:

Sec 25 SWSE: 22.9
 Sec 25 SESE: 11.2

Sec 36 NWNE: 23.3
 Sec 36 SWNE: 6.2 ac
 Sec 36 NENW: 15.7 ac
 Sec 36 SENW: 22.7 ac

Irrigation Acres per Taxlot:

Taxlot 0100: 102.0 ac

All in DLC John Anderson 55

- Permit G-13131 POA
- Permit G-13131 POU
- Actual POU
- Taxlots
- 6" Mainlines
- DLC Boundary

CWM-H2O 
 Complete Water Management


1319 SE MLK, Jr. Blvd, Suite 204
 Portland, Oregon 97214
 (503) 954-1326

Attachment 1
Claim of Beneficial Use Map
App. G-14234, Permit G-13131

This map is not intended to provide legal dimensions or locations of property ownership lines.

0 500 1,000 2,000 ft
 Scale = 1" : 1,320'

Proj#: 2010002
 Fairdale CBU
 Fairdale Nursery
 13200 SW Wilsonville Road
 Wilsonville, OR 97070



RECEIVED

MAR 13 2023

OWRD