


T.4S. R.1W. Section 36 & T.4S. R.1E. Section 31, W.M.

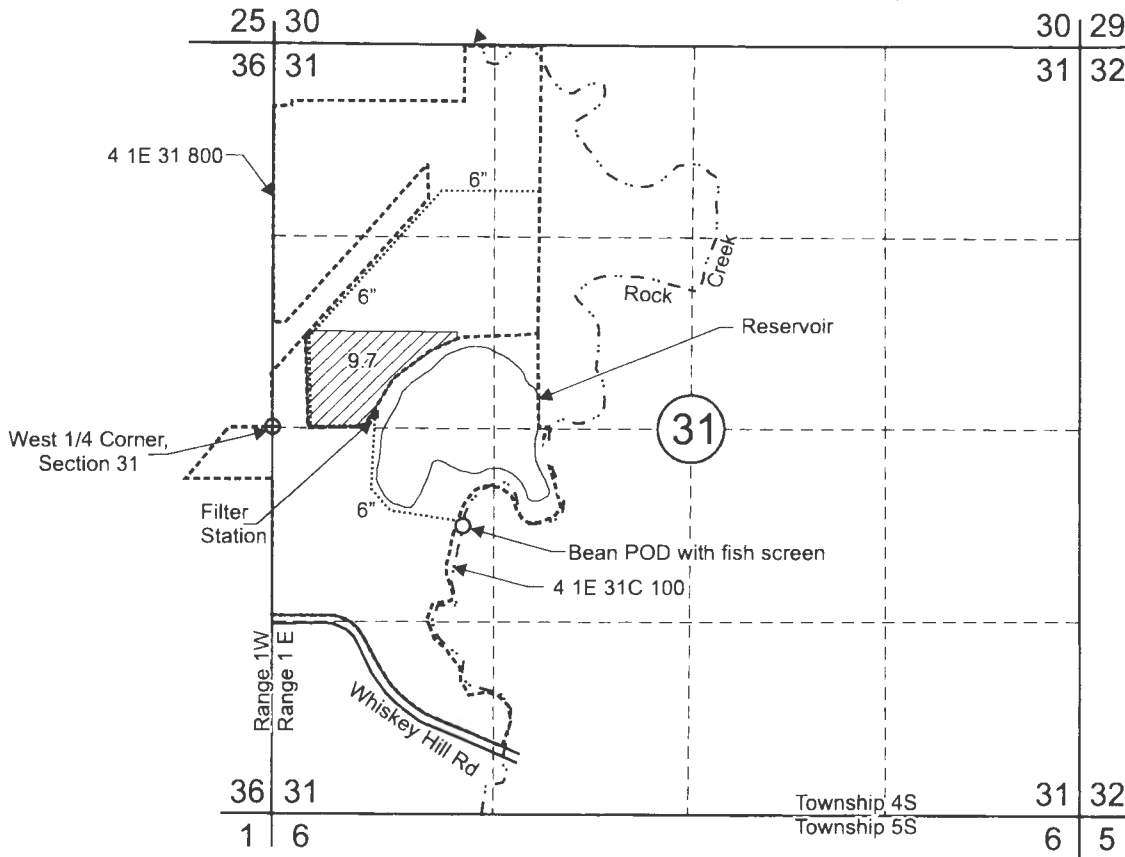

RECEIVED
JUL 28 2021
OWRD

Bean POD is located 675 feet south and 1,280 feet east from the West 1/4 corner, Section 31.

 Area (9.7 acres) irrigated under T-13151 (formerly Certificate 90218), priority date March 5, 1934.

----- Tax lot boundary

..... Mainline



Scale: 1" = 1,320'



This map was prepared for the purpose of identifying the location of a water right only and is not intended to provide legal dimensions or location of property ownership lines.

Claim for Beneficial Use Map
T-13151 formerly Certificate 90218

Pacific Hydro-Geology Inc.

07/2021

Warren H. and Bernice S. Bean
T.4S. R.1W. Section 31, and
T.4S. R.1E. Section 36, W.M