


# T.4S. R.1W. Section 36 & T.4S. R.1E. Section 31, W.M.

RECEIVED

JUL 23 2021

OWRD

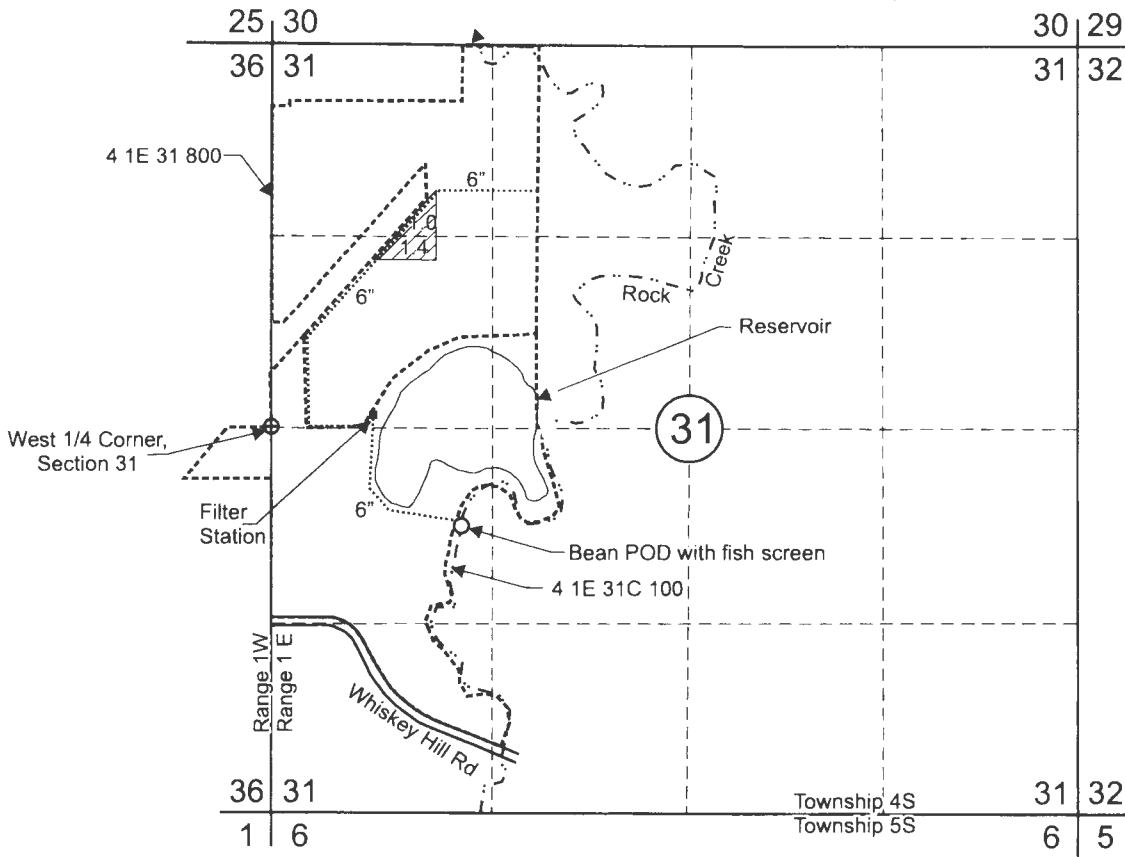

Bean POD is located 675 feet south and 1,280 feet east from the West 1/4 corner, Section 31.

 Area (2.4 acres) irrigated under T-13151 (formerly Certificate 94129), priority date March 5, 1934.


----- Tax lot boundary

..... Mainline



EXPIRES *June 30, 2023*

Scale: 1" = 1,320'

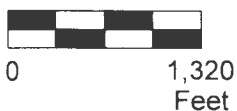

This map was prepared for the purpose of identifying the location of a water right only and is not intended to provide legal dimensions or location of property ownership lines.



Claim of Beneficial Use Map  
T-13151 formerly Certificate 94129

Warren H. and Bernice S. Bean  
T.4S. R.1W. Section 31, and  
T.4S. R.1E. Section. 36, W.M

Pacific Hydro-Geology Inc.

07/2021