


T.4S. R.4W. Sec. 35 & 36, W.M.

RECEIVED

JUN 21 2021

OWRD

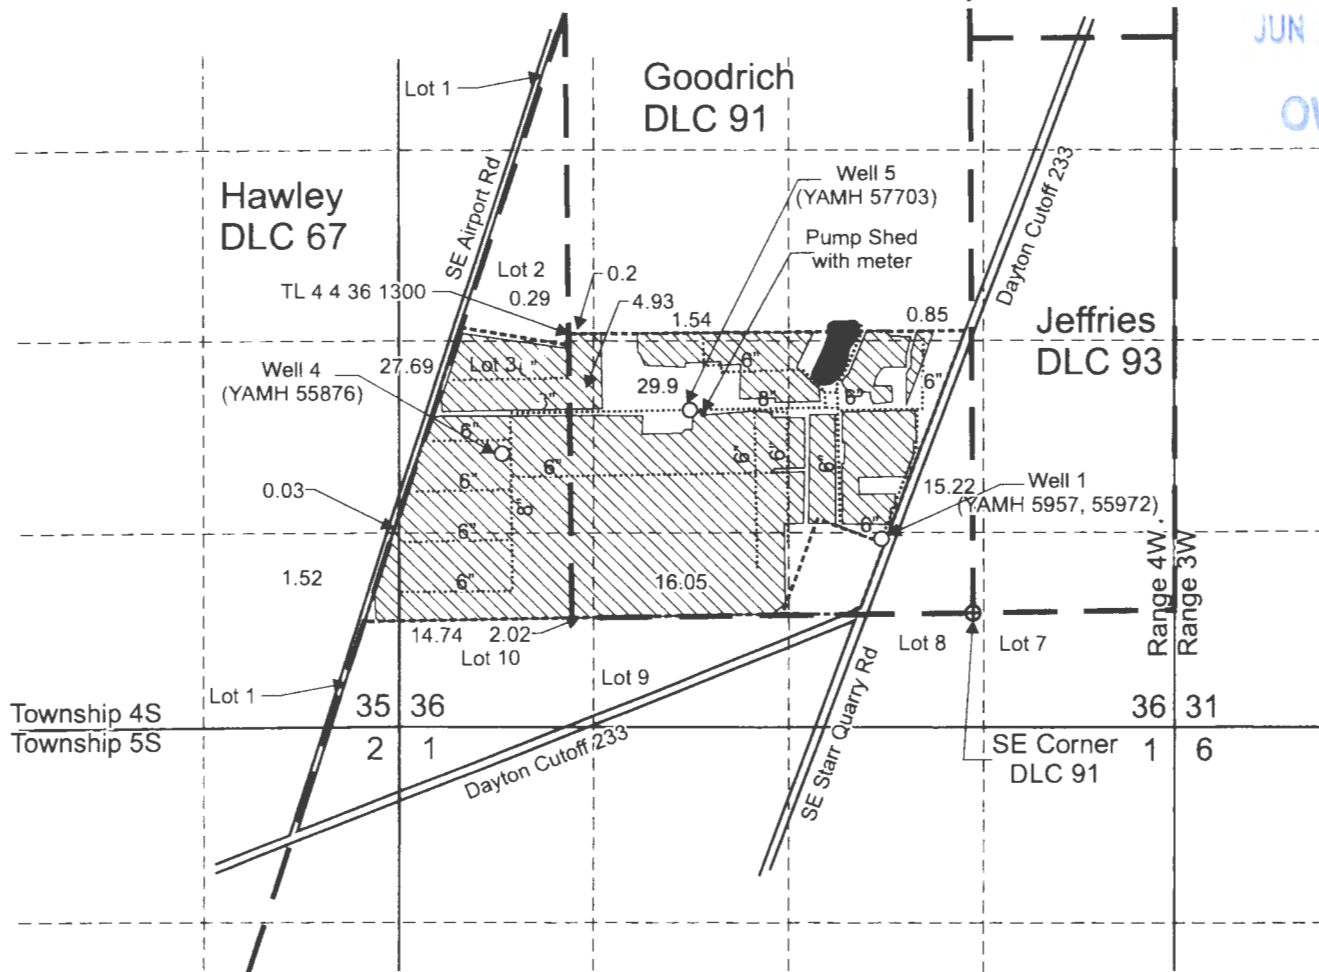

Well 1 (YAMH 5957, 55972) is located 495 feet north and 625 feet west from the SE corner, DLC 91.
 Well 4 (YAMH 55876) is located 1,100 feet north and 3,200 feet west from the SE corner, DLC 91.
 Well 5 (YAMH 57703) is located 1,395 feet north and 1,925 feet west from the SE corner, DLC 91.

 Area (114.98 Acres) irrigation and agricultural use for nursery operations under T-12601, priority January 12, 1998.

- Tax lot boundary
- Donation Land Claim boundary
- Water main line



Scale: 1" = 1,320'



This map was prepared for the purpose of identifying the location of a water right only and is not intended to provide legal dimensions or location of property ownership lines.



Claim of Beneficial Use Map
T-12601

KCK Farms
T.4S. R.4W. Sec. 35 & 36, W.M.

Pacific Hydro-Geology Inc.

05/2021

KCKT-12601COBUMap.cdr