


T.7S., R.2W., W.M.

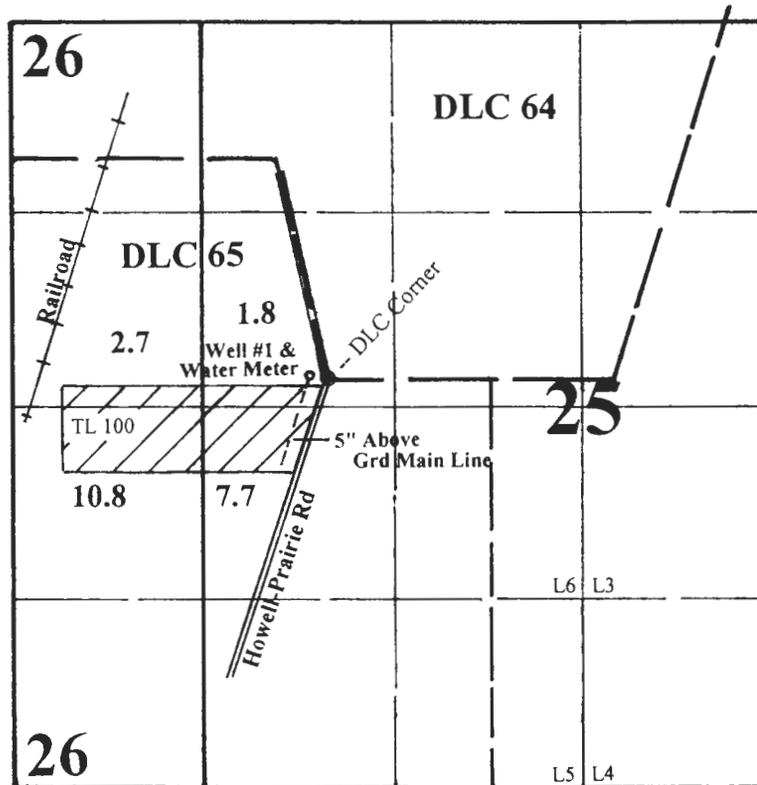

Acreage Involved
in Transfer

Well #1 (New POA) is located 50' N & 100' W from the easterly interior corner of DLC 65.

Claim of Beneficial Use

In the Name of

Kyle Schurter

Transfer: T-12314

Surveyed on May 22, 2018 by JM Schuette

This Map was Prepared for the Purpose of Identifying the Location of a Water Right Only and is Not Intended to Provide Legal Dimensions or Location of Property Ownership Lines.



EXPIRES: 6.30.20