


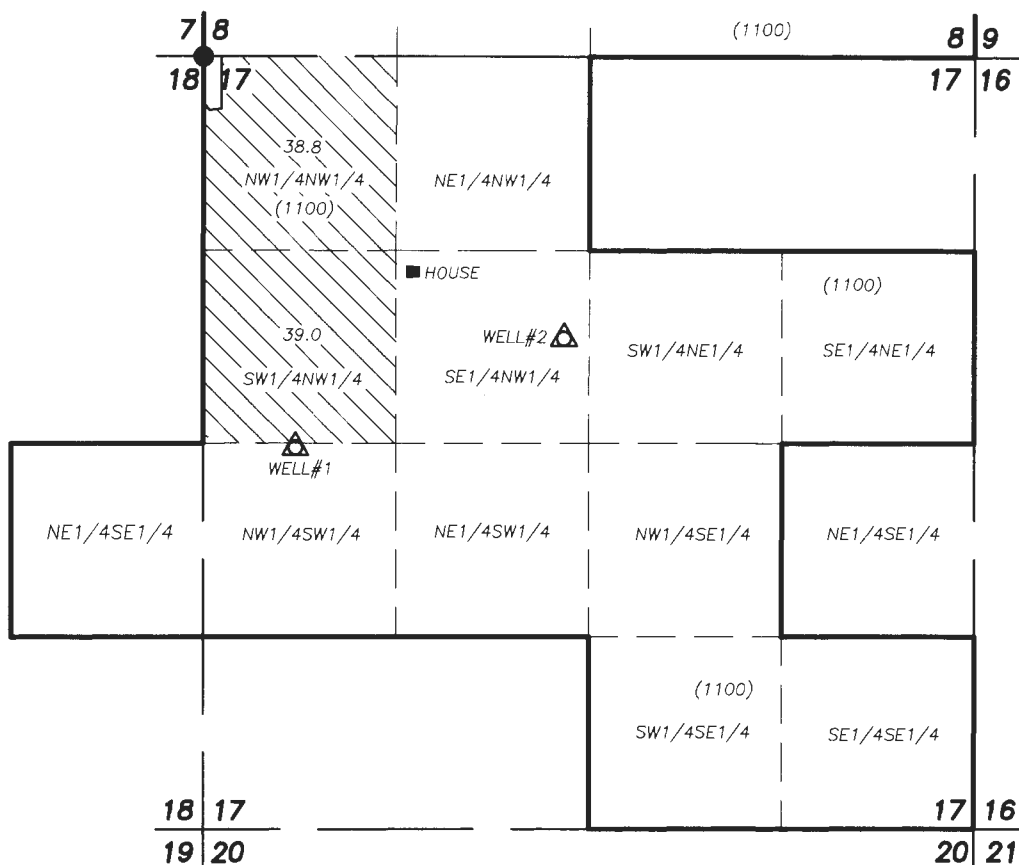

SCALE: 1" = 1320'



CLAIM OF BENEFICIAL USE MAP
UNDER
T-12869
IN NAME OF
M. MARTIN AND ANDREA DAVIES

- △ WELL #1 & FLOW METER: 2670 FT. SOUTH &
630 FT. EAST FROM THE NW COR. SECTION 17
- △ WELL #2 & FLOW METER: 1920 FT. SOUTH &
2470 FT. EAST FROM THE NW COR. SECTION 17

PREPARED BY:
ROBERT D. BAGETT, PLS, CWRE
217 N. CANYON BLVD.
JOHN DAY, OREGON 97845
(541) 575-1251

SEPTEMBER 16, 2021

 PLACE OF USE


() TAX LOT

● FOUND SECTION COR. MONUMENT

RECEIVED

OCT 18 2021

OWRD

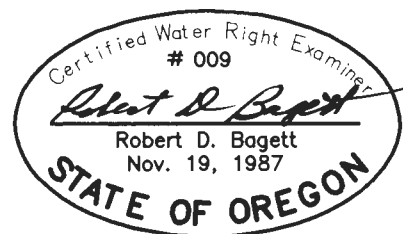

THIS MAP IS NOT INTENDED TO PROVIDE LEGAL DIMENSIONS
OR LOCATIONS OF PROPERTY OWNERSHIP LINES

RENEWS: 12/31/2021