


**T11S R20E, WM
WHEELER COUNTY, OR**

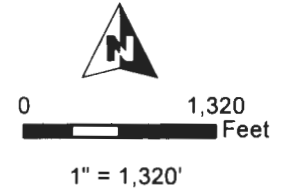


- POD & Fish Screen
- Creek
- POU IR 1877 Priority
- Section
- Quarter Quarter
- Tax Lot

POD Location:
1880' S, 580' W of the NE Cor Sec 35


RECEIVED

APR 12 2021

OWRD

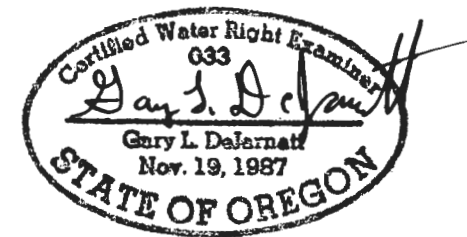

RENEWAL DATE 12/31/2021

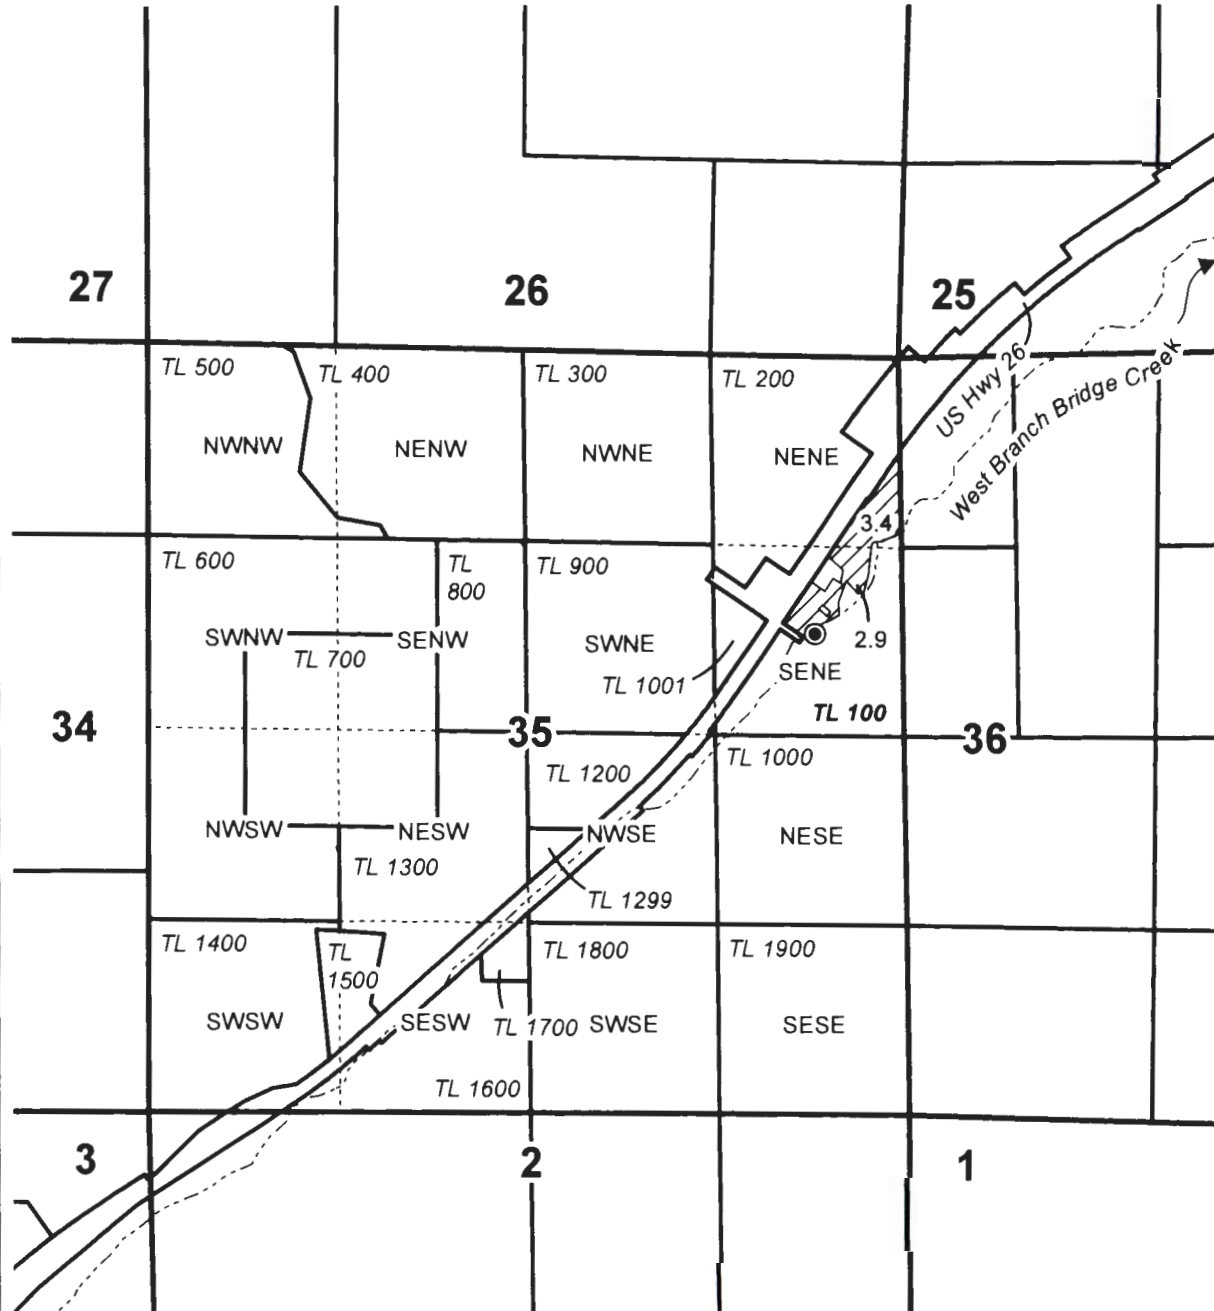

**CLAIM OF BENEFICIAL USE MAP
ROBERT BREEN RANCH**

Date: 10/14/2020

T-9892

Project # 20061

This map is not intended
to provide legal dimensions
or locations of property
ownership lines.

WATER RIGHT SERVICES, LLC
PO BOX 1830, BEND, OR 97709
WWW.OREGONWATER.US CCB # 197121
johnshort@usa.com 541-389-2837