


T.5S. R.3W. Sec. 4, 5, and 8, W.M.

RECEIVED
AUG 26 2020

OWRD

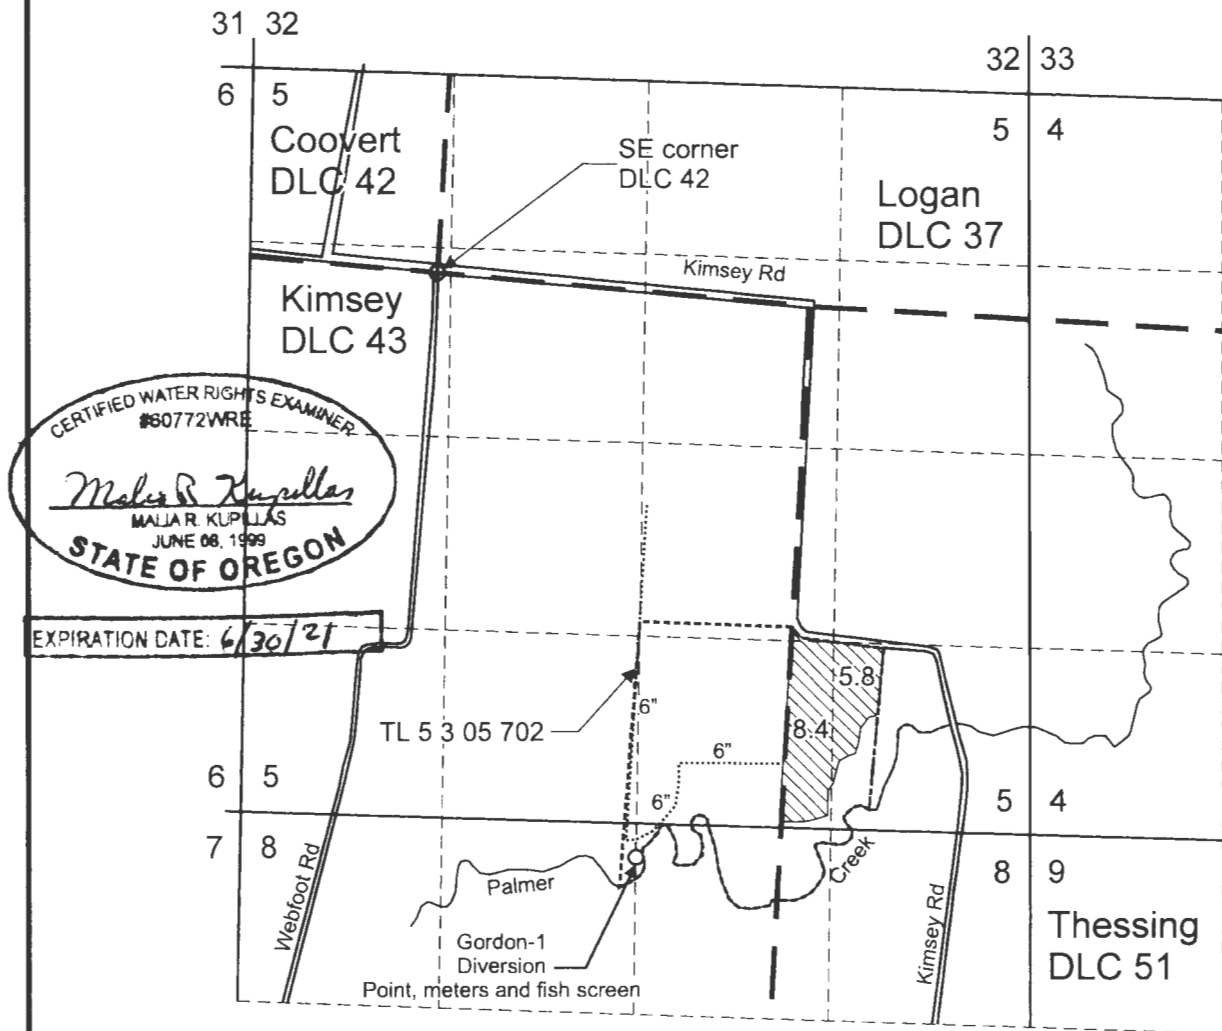

Gordon-1 point of diversion is located 4,020 feet south and 1,350 feet east from the SE corner, DLC 42.

 Area (14.2 Acres) irrigated by Certificate 19850, priority date July 18, 1946.

-  DLC boundary
-  Tax lot boundary
-  Mainline

Note: The quarter quarter lines have been projected using a tax map, government land survey maps, an aerial photograph, and best professional judgement.

This map was prepared for the purpose of identifying the location of a water right only and is not intended to provide legal dimensions or location of property ownership lines.

Scale: 1" = 1,320'



Pacific Hydro-Geology Inc.

Claim of Beneficial Use Map
Transfer T-12825

Carlton Nursery Co., LLC.
Gordon/Ediger/Webfoot

7/7/2020 revised

T.5S. R.3W. Sec. 4, 5, and 8, W.M.