
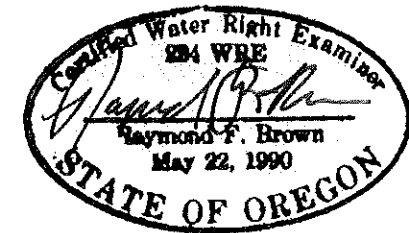


SECTION 1 & 12, T. 32 S., R. 3 W., W.M.

SCALE: 1" = 400'

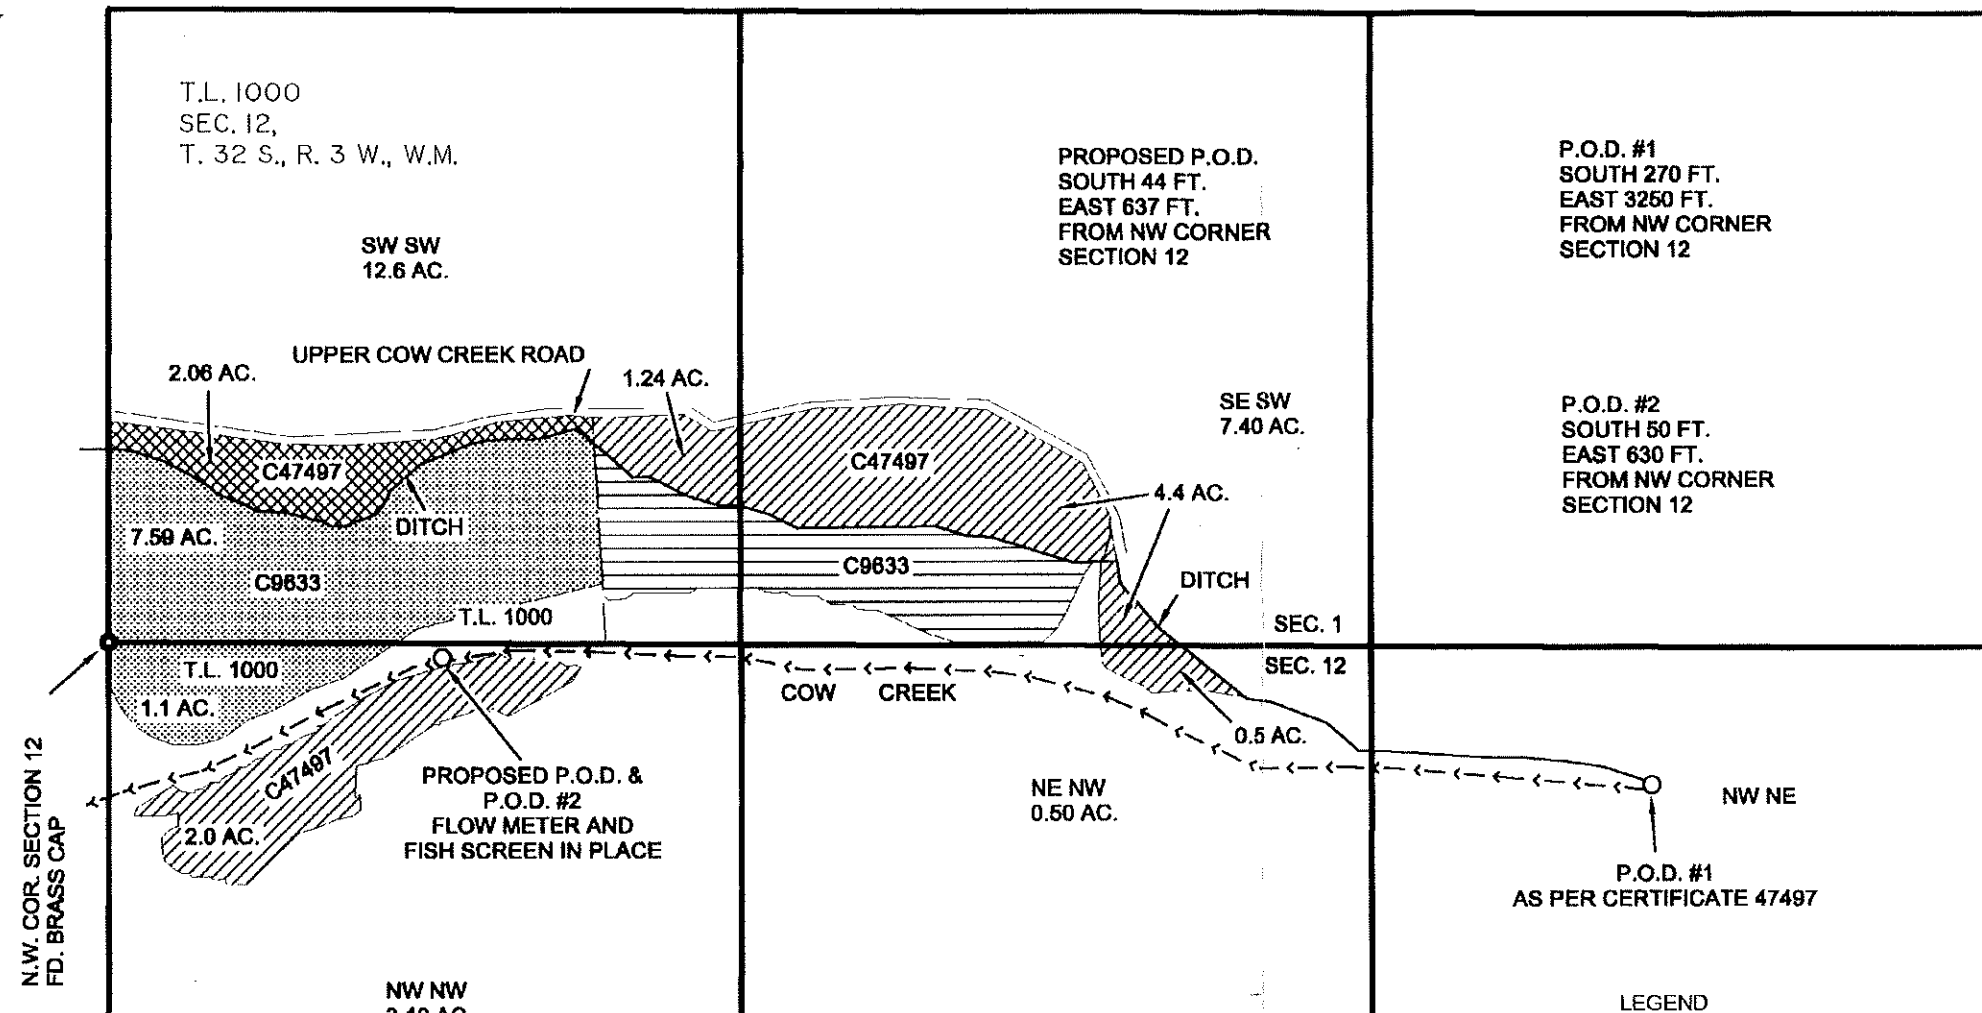

EXP. 12/31/2017

THE PURPOSE OF THIS MAP IS TO IDENTIFY THE LOCATION OF THE WATER RIGHT. IT IS NOT INTENDED TO PROVIDE INFORMATION RELATIVE TO THE LOCATION OF PROPERTY OWNERSHIP BOUNDARY LINES.

FINAL PROOF SURVEY

UNDER

Application No. T-11787

IN NAME OF

PATRICIA WATTERSON AND MARY BUDDENHAGEN

Surveyed October 15, 2016 by: **R. F. BROWN**

LEGEND

- SEC. CORNER FOR SEC. 1, 2, 11, & 12
-  AREA OF DECREE C9633 NOT BEING EFFECTED (4.71 AC.)
-  AREA OF CERTIFICATE 47497 NOT BEING EFFECTED (8.4 AC.)
-  AREA OF C9633 EFFECTED BY TRANSFER (7.59 AC. SEC. 1, 1.10 AC. SEC. 12)
-  AREA OF CERTIFICATE 47497 EFFECTED BY TRANSFER (2.06 AC. SEC. 1)

RECEIVED BY OWRD

SEP 29 2017

SALEM, OR

2001 MAP # 2001