

**LEGEND**


- Point of Diversion (POD)
- ▨ Place of Use (POU) for Former Certificate 81322
- ▨ POU for Former Certificate 83673
- ▭ Counties
- ▭ Donation Land Claim (DLC)
- ▭ Government Lot (GL)
- ▭ Tax Lots
- Conveyance Mainline
- ~ Watercourse
- Waterbody

**POD LOCATION DESCRIPTION:**

**Willamette River Diversion**  
 1650' South and 1000' East from the SW Corner of Section 23, Township 9 South, Range 4 West, W.M.

**MAP NOTES:**

Date: September 19, 2013  
 Data Sources: OWRD, BLM, USGS, ESRI

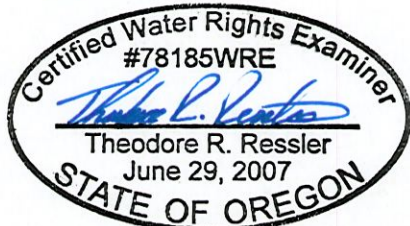

EXPIRES: 12-31-2014

RECEIVED BY OWRD

OCT 21 2013

SALEM, OR

**Claim of Beneficial Use**

Transfer T-9662 (Permit S-52679)

Townships 9 South, Range 4 West (W.M.)

