


WATER RIGHTS TRANSFER APPLICATION MAP

PERMIT NO. S-2346/CERTIFICATE NO. S-6424
 LOCATED IN TOWNSHIP 29 SOUTH, RANGE 12 WEST, SECTIONS 22, 23 & 27

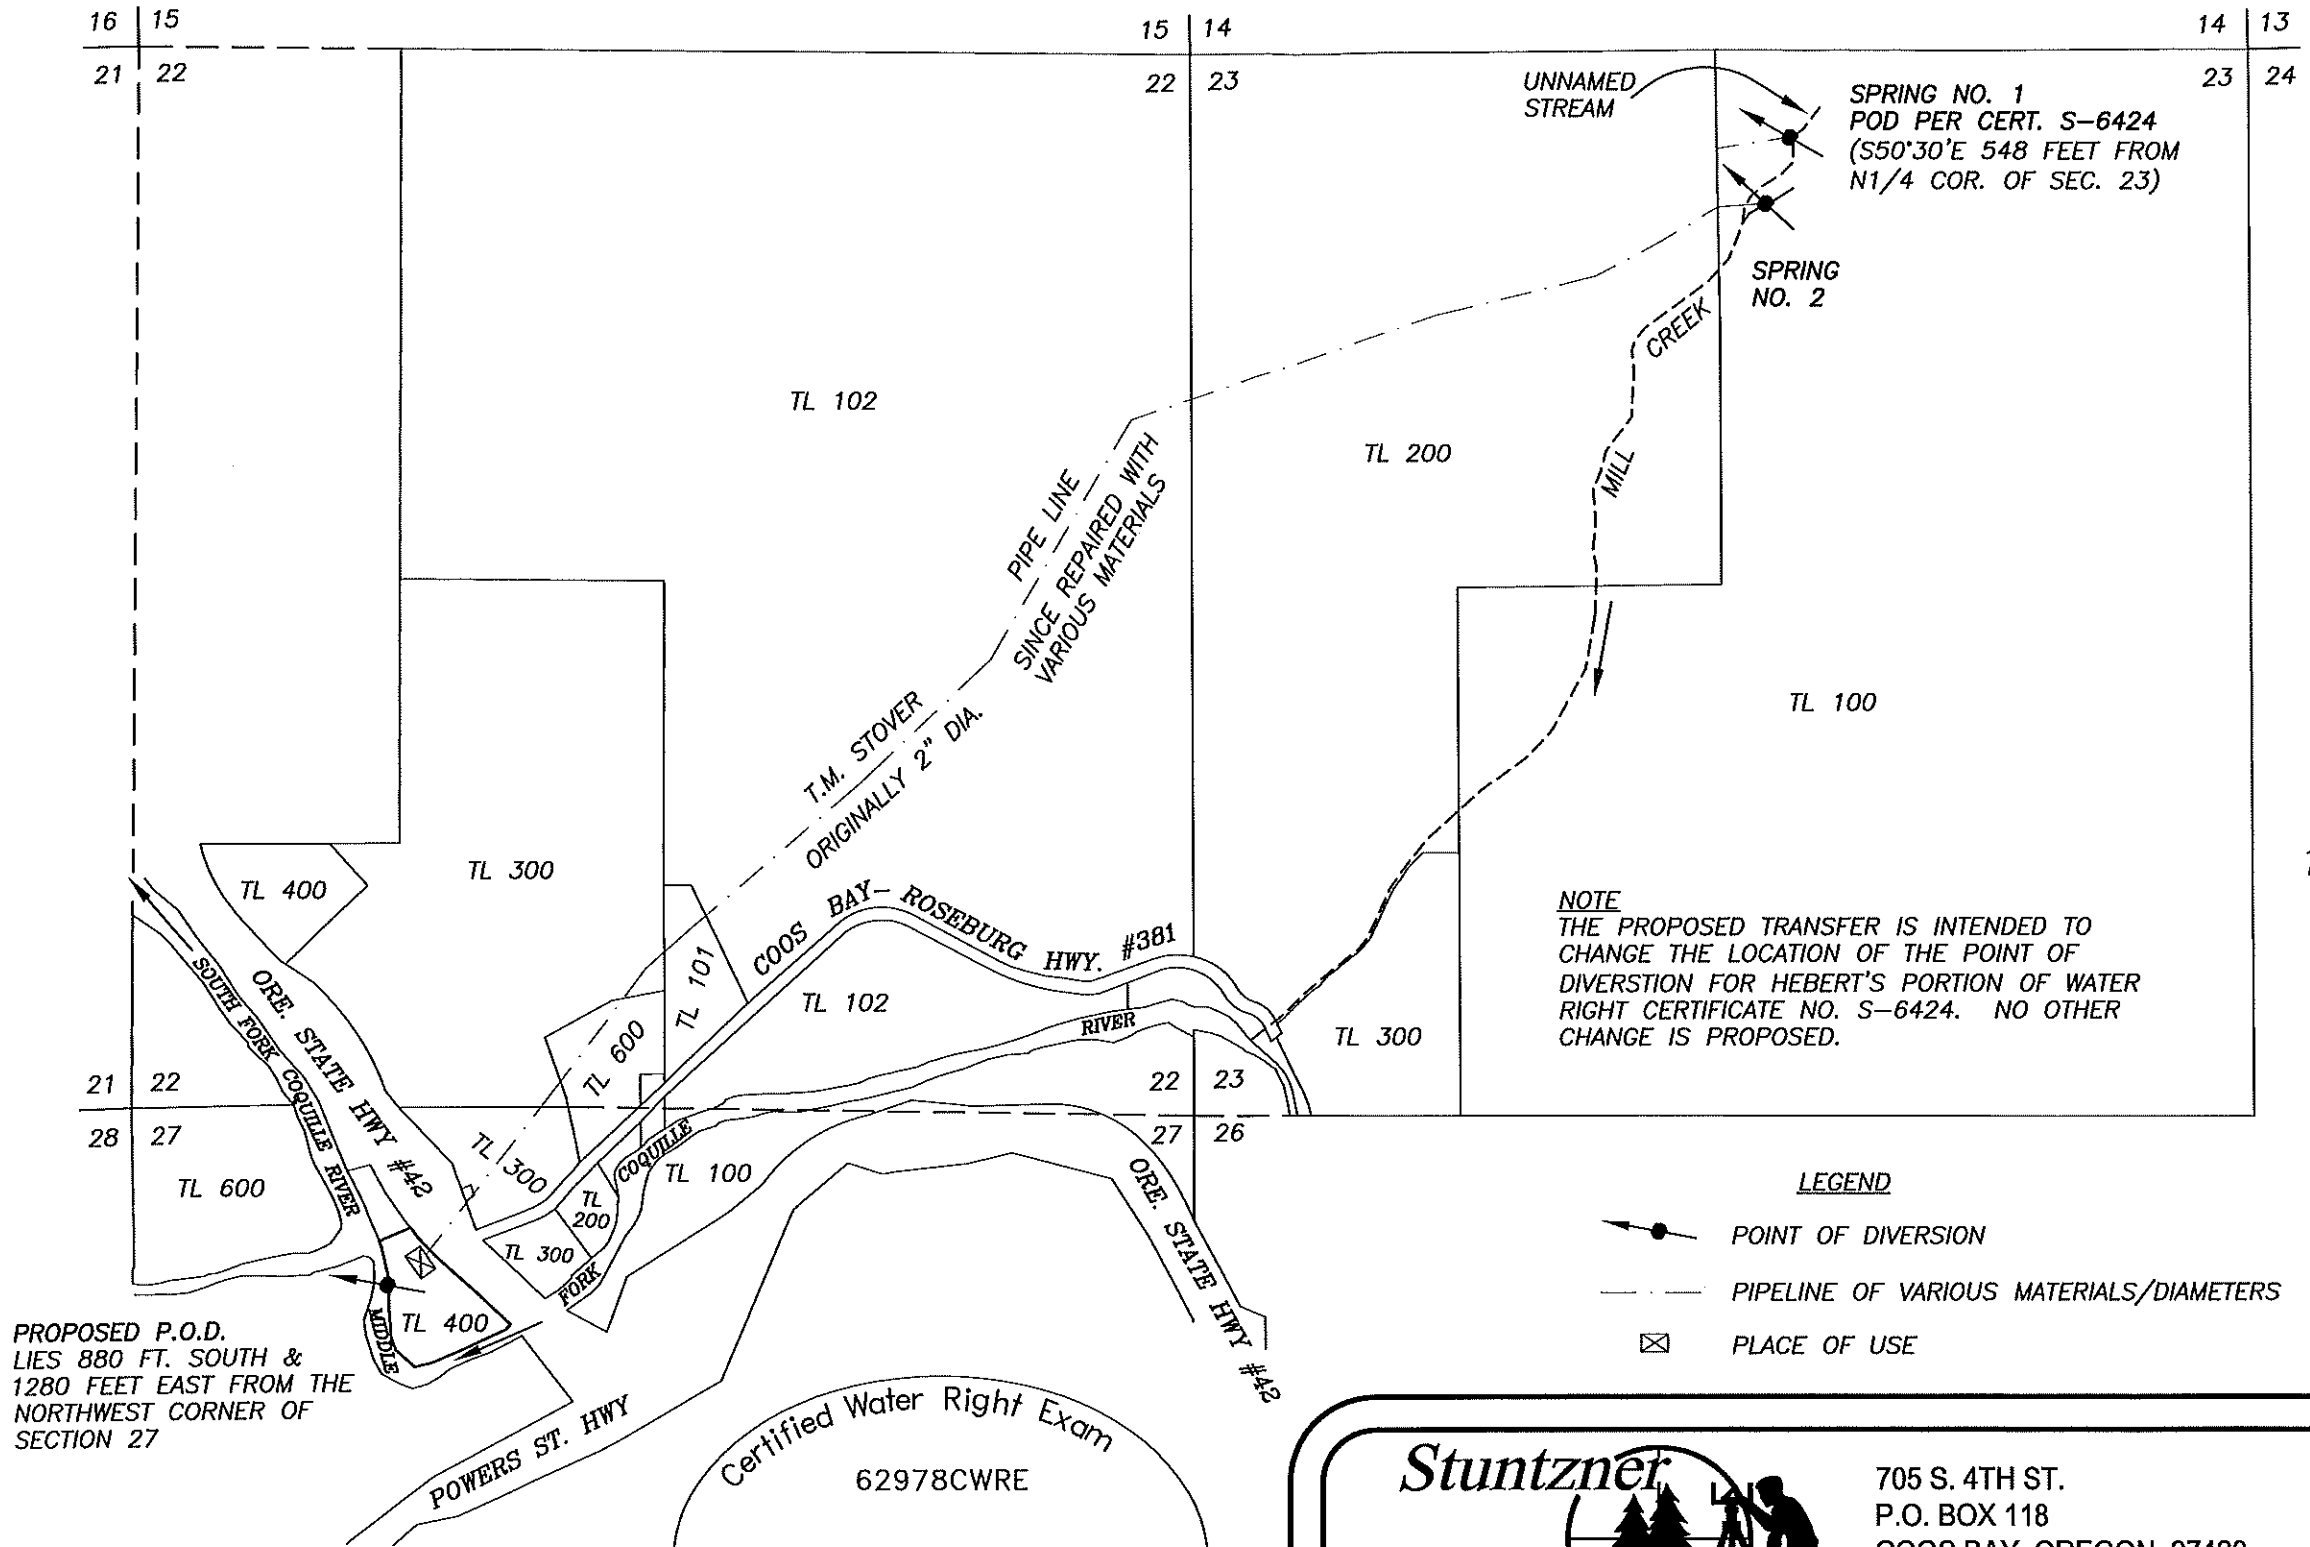


NOTE
 THE PROPOSED TRANSFER IS INTENDED TO CHANGE THE LOCATION OF THE POINT OF DIVERSION FOR HEBERT'S PORTION OF WATER RIGHT CERTIFICATE NO. S-6424. NO OTHER CHANGE IS PROPOSED.

LEGEND

- POINT OF DIVERSION
- PIPELINE OF VARIOUS MATERIALS/DIAMETERS
- PLACE OF USE

PROPOSED P.O.D. LIES 880 FT. SOUTH & 1280 FEET EAST FROM THE NORTHWEST CORNER OF SECTION 27

NOTE:
 CURRENTLY PLACE OF USE HAS SEVERAL STORAGE TANKS TOTALLING APPROXIMATELY 15,000 GALLONS OF STORAGE

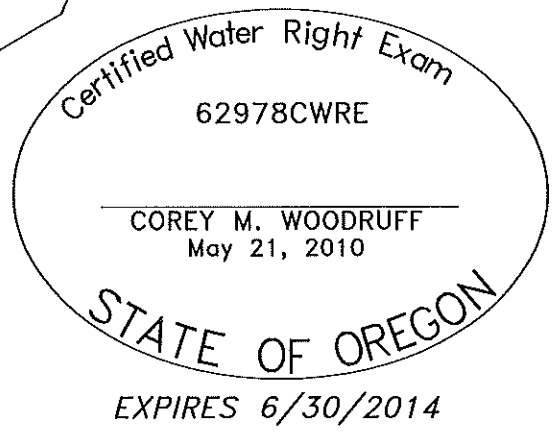

		705 S. 4TH ST. P.O. BOX 118 COOS BAY, OREGON 97420 Engineering - Land Surveying - Forestry - Land Planning - Water Rights	PHONE: (541) 267-2872 FAX: (541) 267-0588 www.stuntzner.com
JOB #: 113-102 DATE: March 2014 DRAWN BY: CMW CHECKED BY: DRG	PREPARED FOR: Steven Hebert Coos Bay, Oregon	FILE NAME: 113-102 Hebert transfer.dwg	
			SHEET 1 OF 1