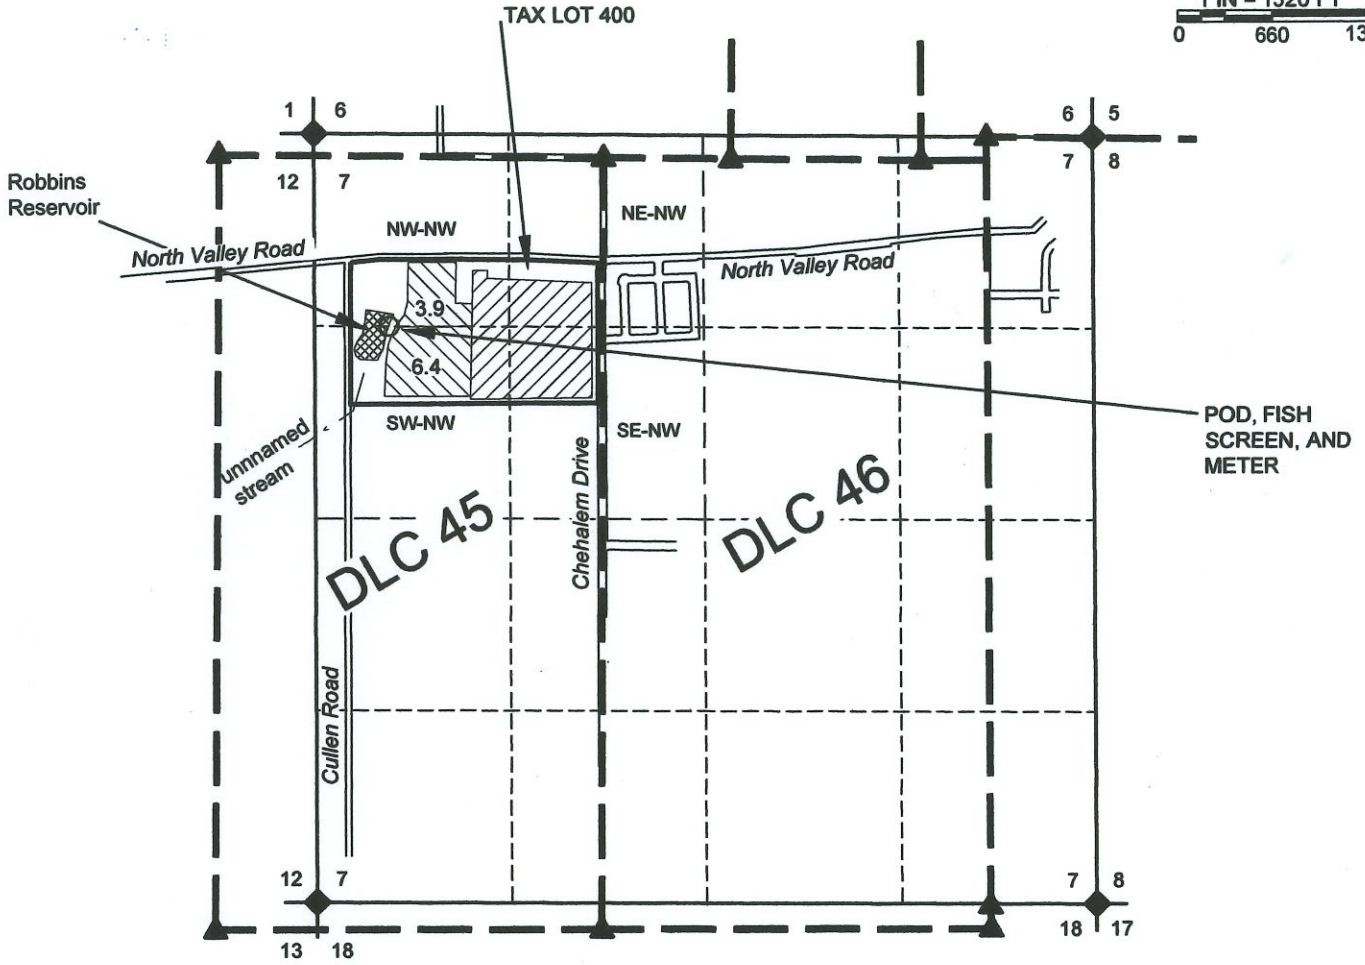


MAP FOR  
**Claim of Beneficial Use**  
 S7, T3S, R2W, Yamhill County  
 Application S-88584, Permit S-55154



1 IN = 1320 FT  
 0 660 1320





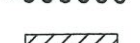






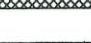


LOCATION OF POD:  
 1500' S & 370' E FROM NW S7 (PER CERTIFICATE 45844)

NOTES:

- THIS MAP IS NOT INTENDED TO PROVIDE LEGAL DIMENSIONS OR LOCATIONS OF PROPERTY OWNERSHIP LINES.
- DLC LINES, PROPERTY LINES AND QUARTER-QUARTER LINES ARE BASED ON THE TAX ASSESSOR MAP FOR SECTION 7, T3S, R2W.
- THE IRRIGATION AREA FOR CERT. 45844 IS BASED ON THE CERTIFICATE MAP.
- THE IRRIGATION FOR PERMIT S-55154 IS BASED ON A 2021 AERIAL PHOTO AND FIELD OBSERVATIONS.
- WATER CONVEYANCE LINES ARE ALL WITHIN THE PROPERTY AND THEREFORE ARE NOT SHOWN.

LEGEND

-  DONATION LAND CLAIM (DLC) CORNER
-  SECTION CORNER
-  POINT OF DIVERSION (POD)
-  STREAM OR SURFACE DRAINAGE
-  TAX LOT LINE
-  SECTION LINE
-  QUARTER-QUARTER LINE
-  DLC LINES
-  CONVEYANCE LINES (NONE SHOWN)
-  Cert. 45844 Irrigation
-  Permit S-55154 Irrigation
-  Reservoir

RECEIVED

SEP 22 2022

OWRD



Exp. JUL 2024

MAP BY:  
**ASPEN RURAL LAND CONSULTING**  
 ERIC URSTADT, PE, PLS  
 971-250-1520  
 SEP 2022  
 FlayingFeather-Robbins3A