


Claim of Beneficial Use Map
App # G-17931 Permit # 17585
James W. Votto


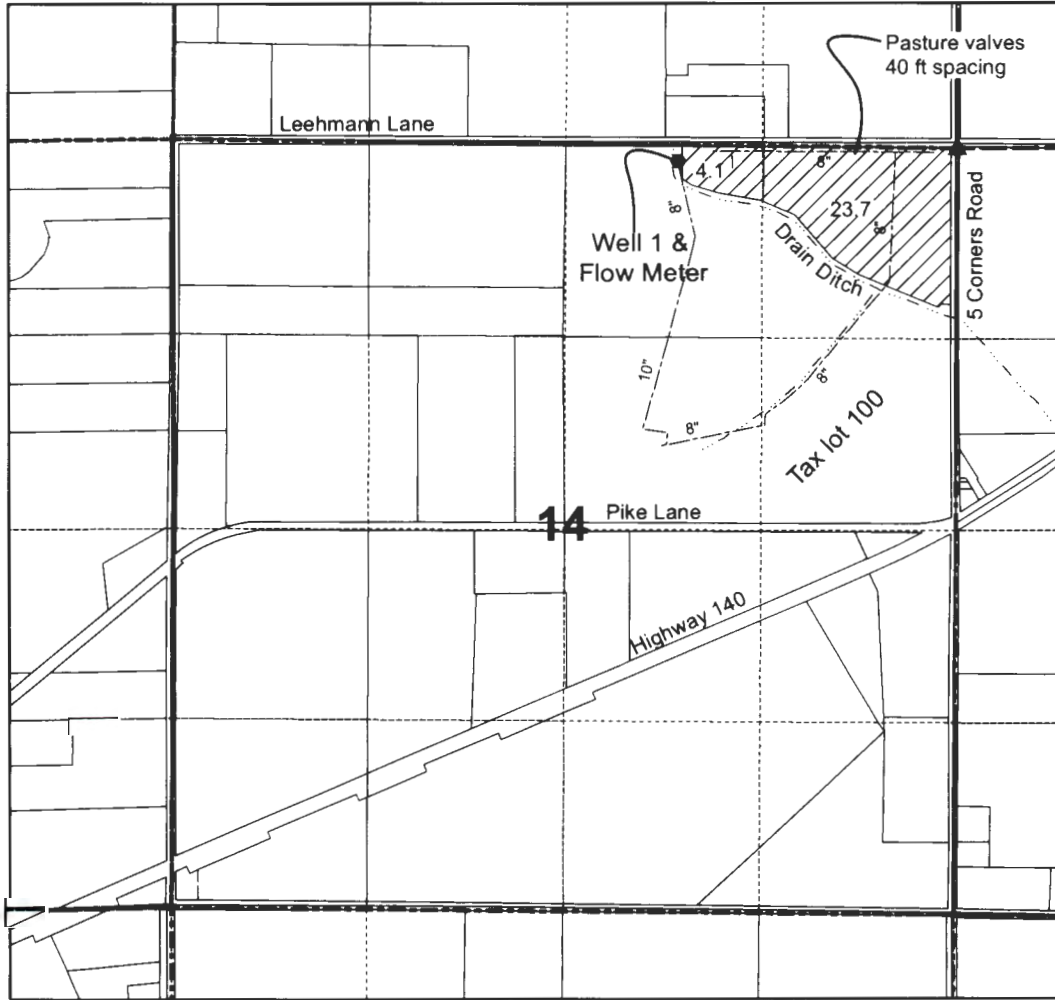


T 39 S, R 19 E, WM
 Section 14
 NE 1/4


RECEIVED
 JAN 13 2020
 OWRD



Well is located
 132 ft South & 1850 ft West
 From NE Cor. Sec 14, T39S, R19E

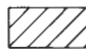 Legend

-  Area of use 27.8 ac
-  Pipeline
-  Drain Ditch
-  Found RR spike per survey 4022

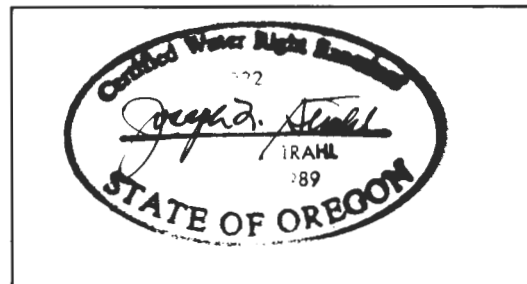

Note: This map is not intended to provide legal dimensions or locations of property ownership lines.

