



RECEIVED BY OWRD

DEC 06 2013

APPLICATION MAP FOR A CLAIM OF BENEFICIAL USE
IN THE NAME OF: COOS BAY NORTH BEND WATERBOARD

Application S-23996 Permit S-26223
S-33089 DC WRD

POINT OF DIVERSION LOCATED IN THE NORTHWEST 1/4 OF SECTION 7,
TOWNSHIP 26 SOUTH, RANGE 13 WEST OF THE WILLAMETTE MERIDIAN.
TAX LOT 200, TAX MAP: 26-13-7

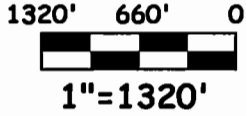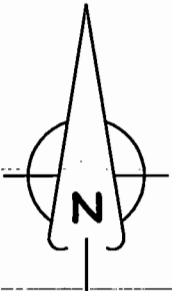

APPLICANTS:
COOS BAY NORTH BEND
WATERBOARD
PO BOX 539
COOS BAY, OR 97420-0108

PREPARED BY:
SHANNON SOUZA, CWRE
SOL COAST CONSULTING &
DESIGN LLC
65431 MILLICOMA RD.
COOS BAY, OREGON 97420


LEGEND:
FOUND GOVT.
CORNER



POINT OF
DIVERSION

POINT OF DIVERSION IS 597
FEET SOUTH AND 543 FEET
WEST OF THE NORTH 1/4
CORNER OF SECTION 7 T26S
R13W

SALEM, OR

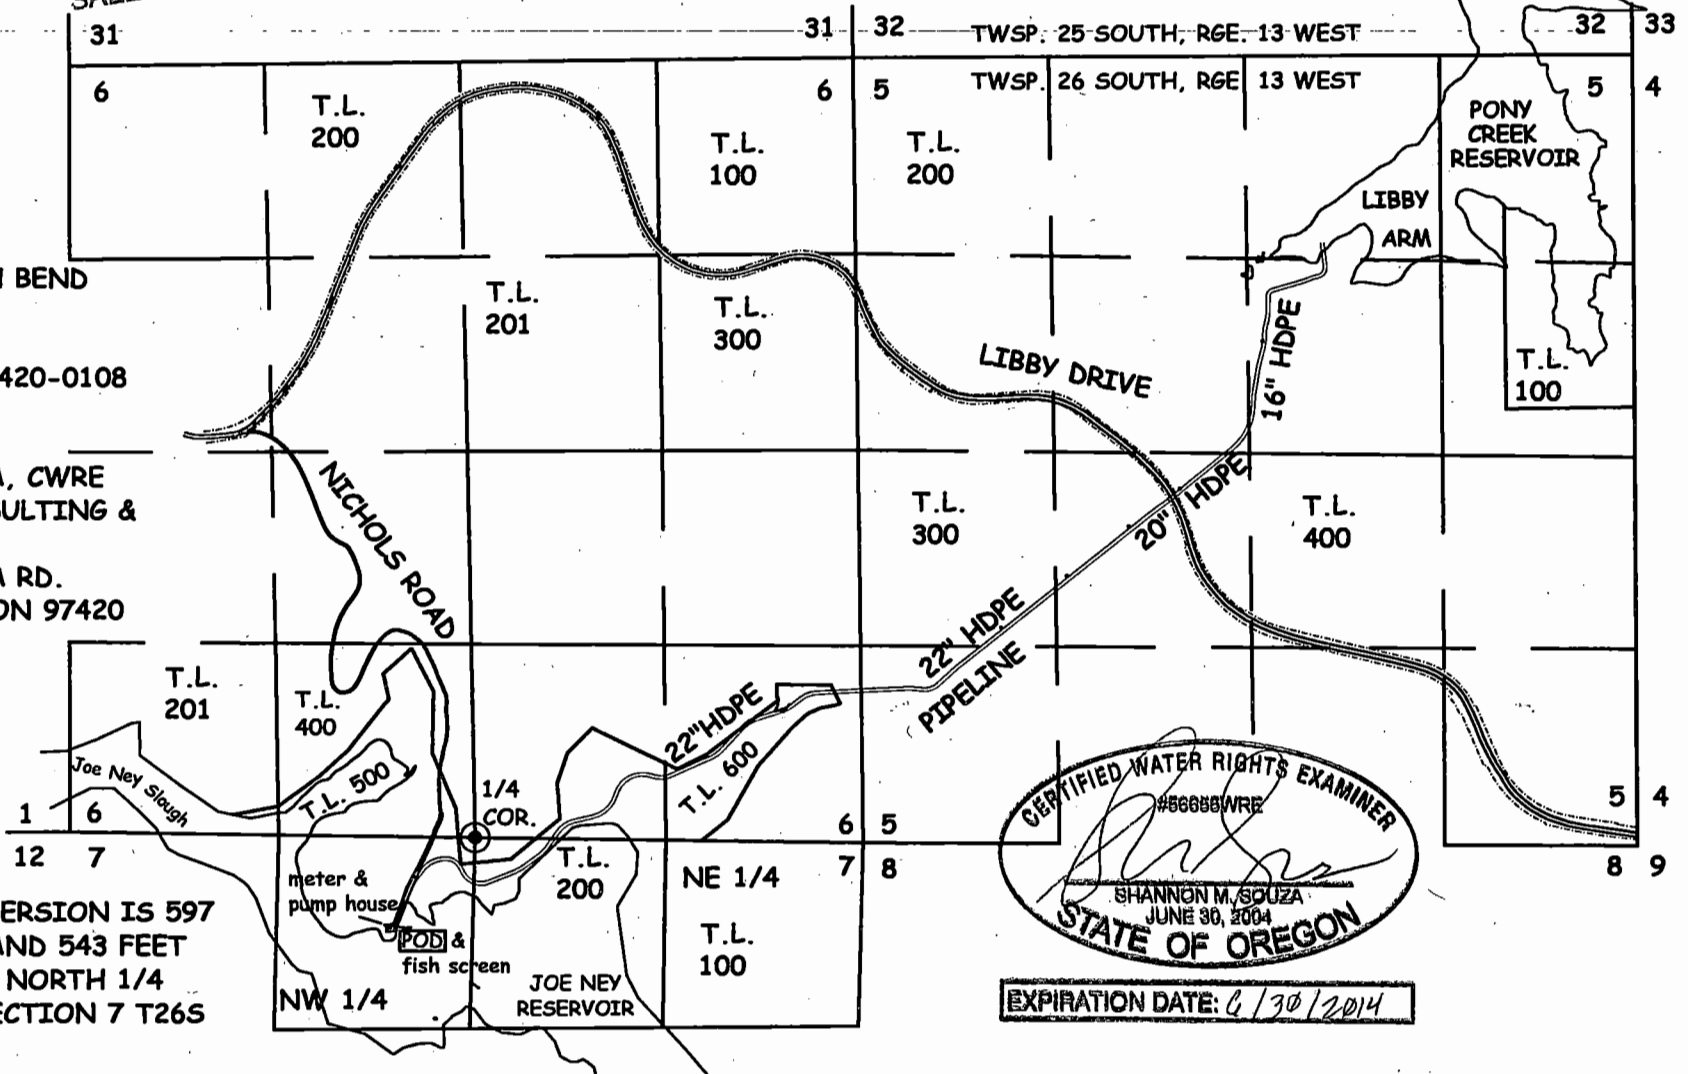

EXPIRATION DATE: 6/30/2014

THE PURPOSE OF THIS MAP IS TO IDENTIFY THE LOCATION OF THE WATER RIGHT THIS MAP IS NOT
INTENDED TO PROVIDE LEGAL DIMENSIONS OR LOCATIONS OF PROPERTY OWNERSHIP LINES.



PAGE 1 OF 1

www.solcoast.com

Sustainable Building/ Renewable Energy/ Environmental Consulting
LICENSED, BONDED, & INSURED: CCB# 164208
65431 Millicoma Ln., Coos Bay, OR 97420
541-266-0877 www.solcoast.com

CLAIM OF BENEFICIAL USE MAP FOR THE COOS BAY- NORTH BEND WATERBOARD

POINT OF DIVERSION LOCATED IN THE NW 1/4 OF SEC. 7, TWP 26 SOUTH, RGE 13 W.W.M

SCALE: 1" = 1320'

DATE: NOVEMBER 4, 2013









DESIGNED BY: T. CAMPBELL

CHECKED BY: S. SOUZA

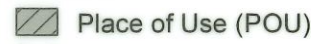

**Claim of Beneficial Use Map
Permit S-26223
(Application S-33089)**
A Water Right in the Name of Coos
Bay North Bend Water Board
Township 25 and 26 South,
Range 13 and 14 West

LEGEND

-  Place of Use (POU)
-  CBNBWB Service Area
-  Donation Land Claim (DLC)
-  Government Lot (GL)
-  Railroad
-  Major Road
-  Watercourse
-  Waterbody

RECEIVED

SEP 17 2021


OWRD

CERTIFIED WATER RIGHTS EXAMINER STAMP




DISCLAIMER

This map was prepared for the purpose of identifying the location of a water right only and it is not intended to provide legal dimensions or location of property ownership lines.

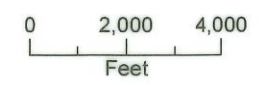

Date: June 30, 2021
Data Sources: BLM, OWRD, ESRI, ODOT, USGS, Coos Co.

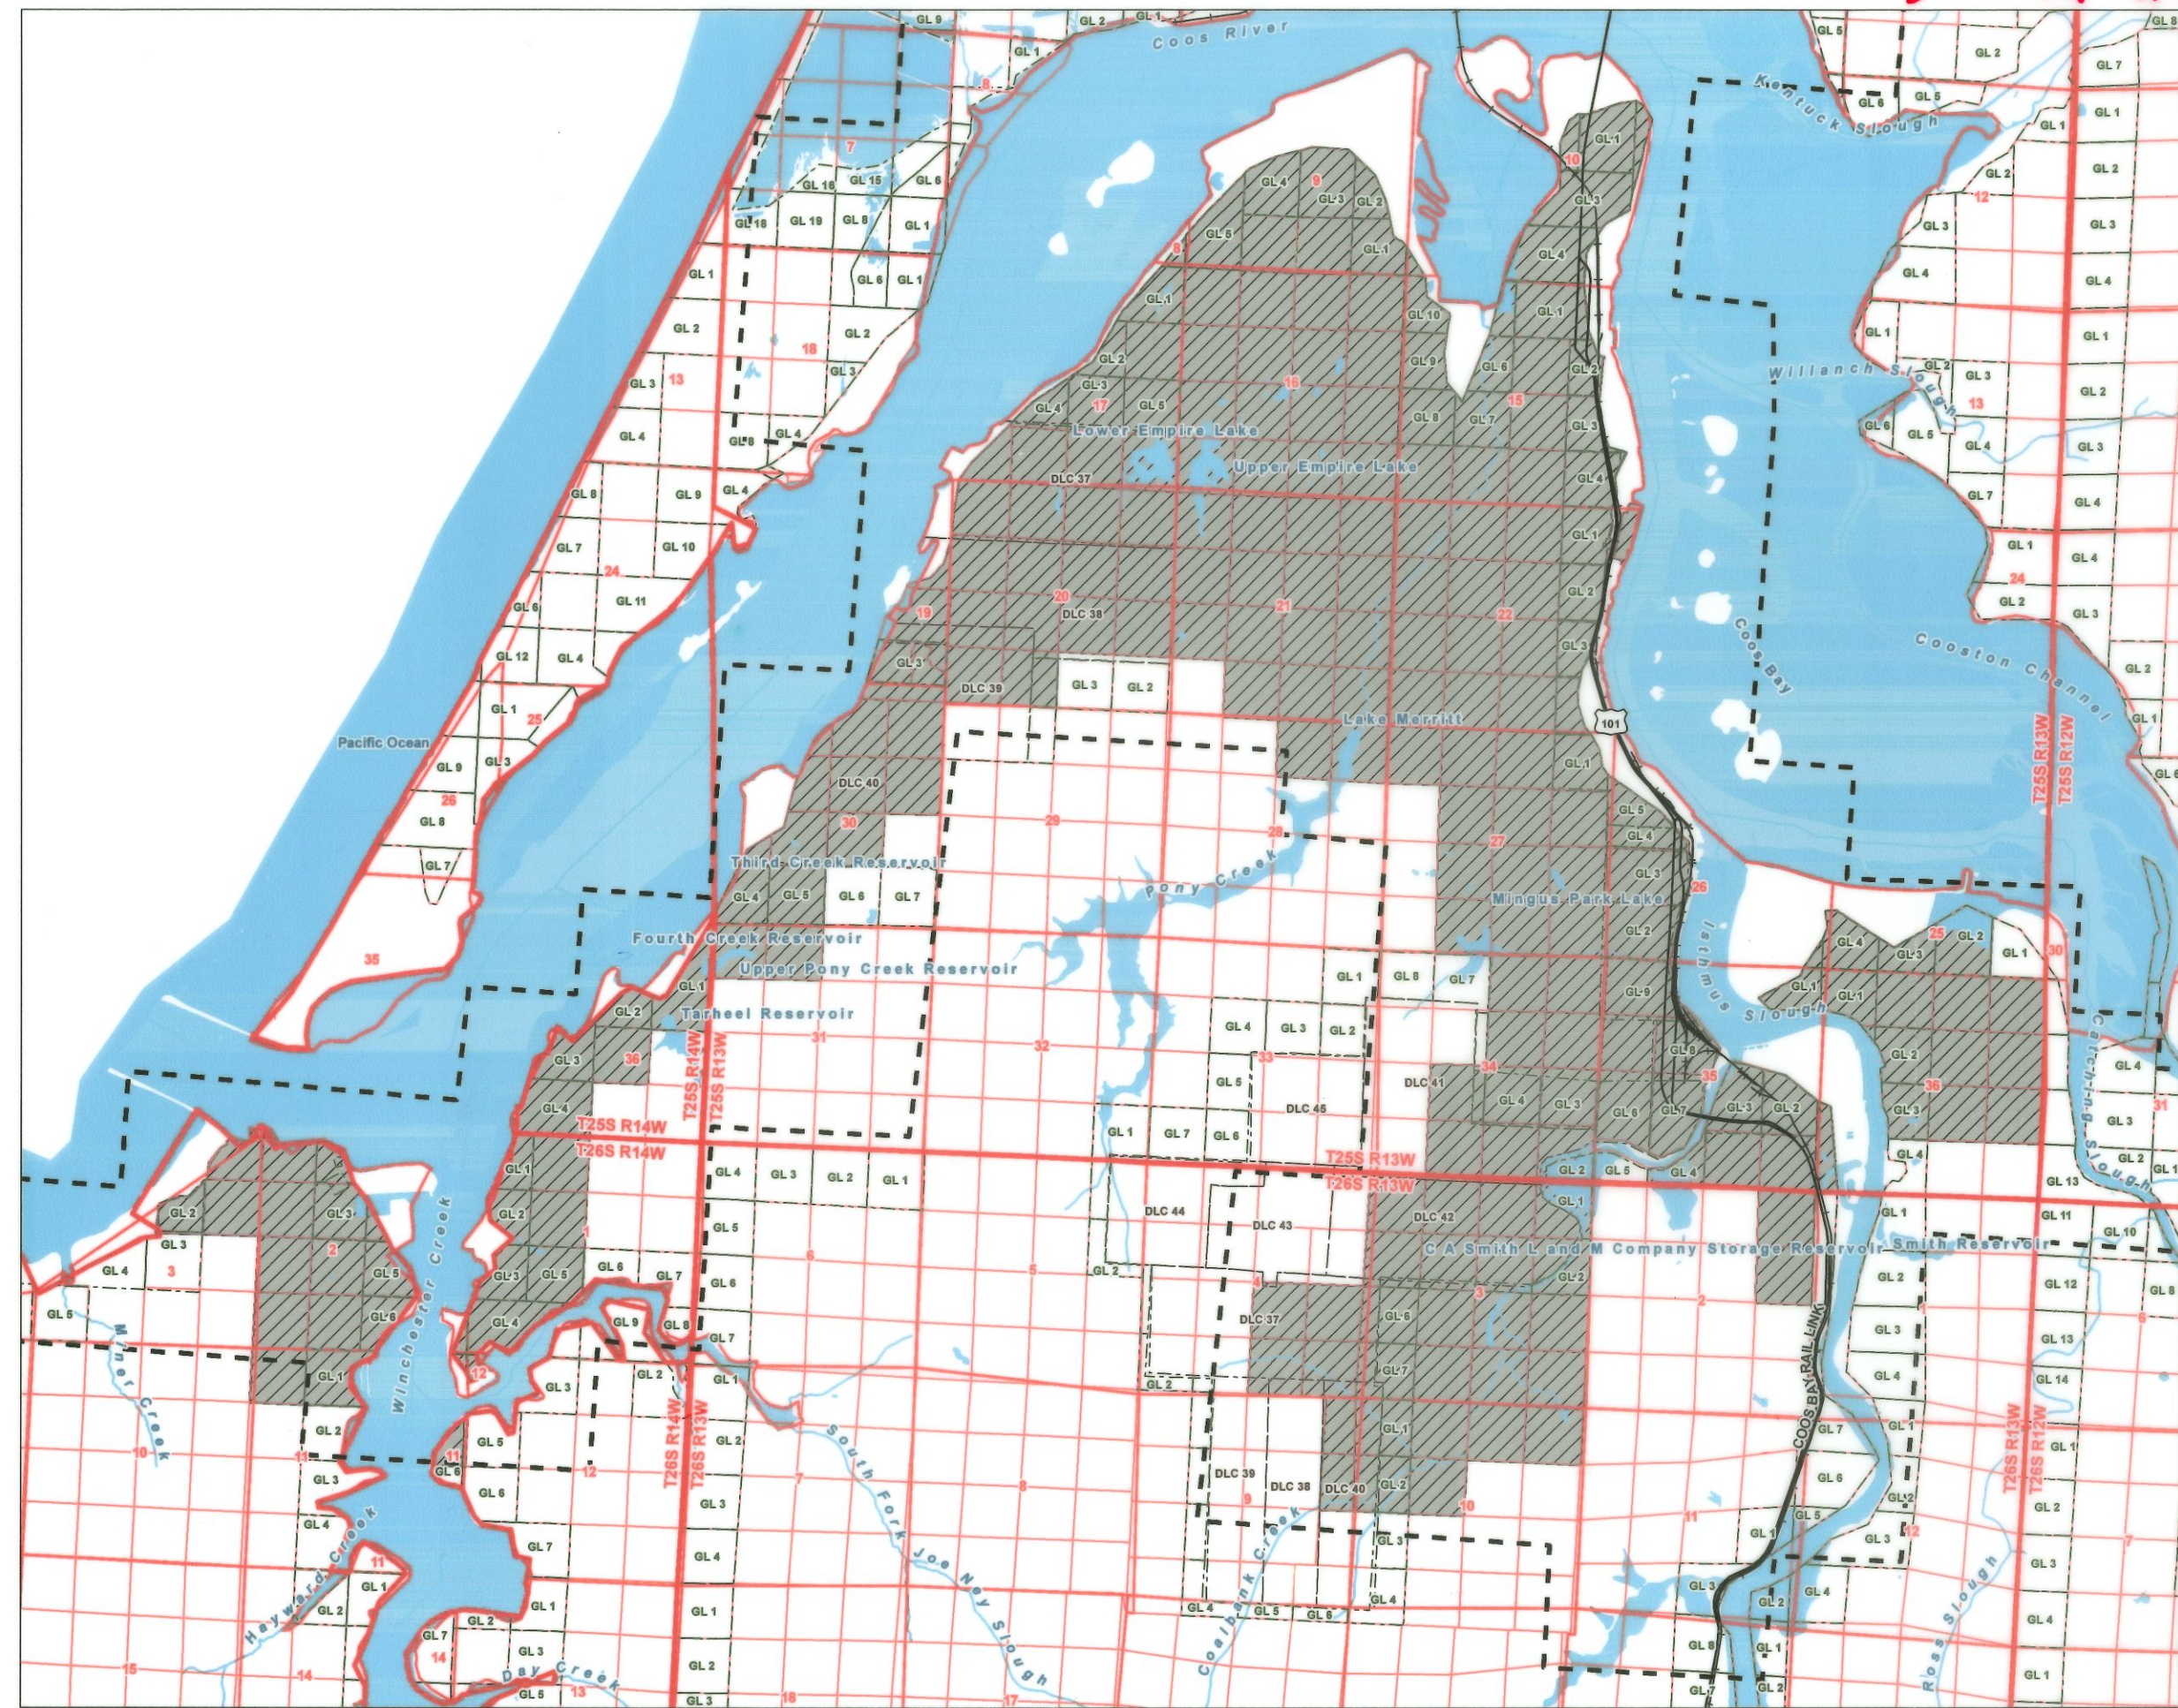

COBU MAP #1310