


T6S R1E, WM

CLACKAMAS COUNTY

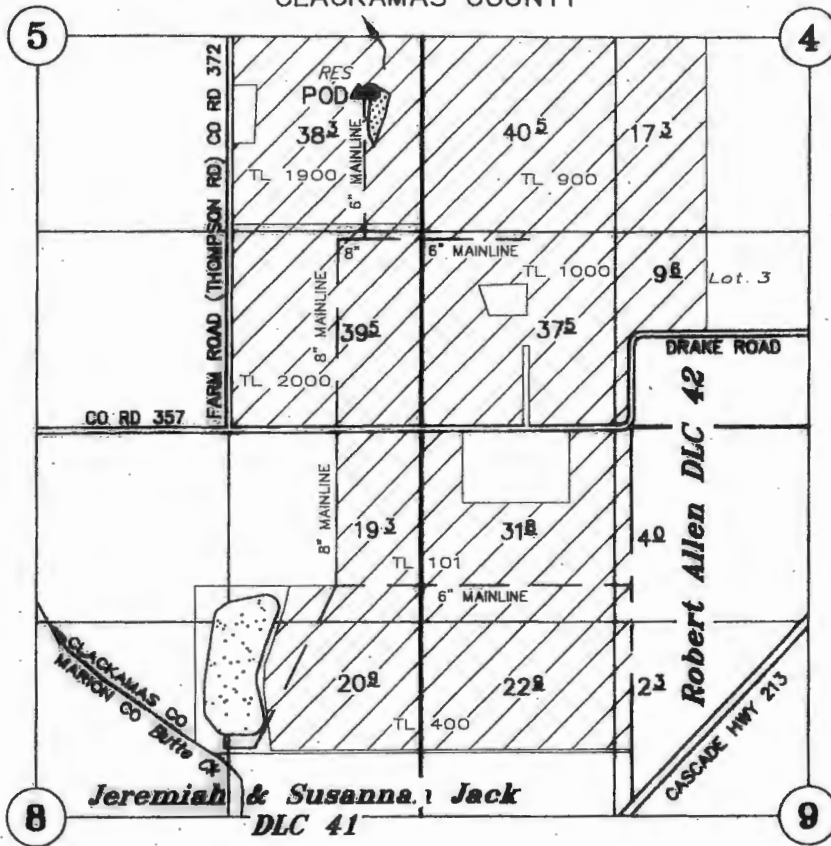

TAX LOT:

- 6S 1E 4 900
- 6S 1E 4 1000
- 6S 1E 5 1900
- 6S 1E 5 2000
- 6S 1E 8 101
- 6S 1E 8 400

POD: 2280' N & 340' W OF SE COR SEC 5 ●
 METER: 2280' N & 345' W OF SE COR SEC 5 ▲

CLAIM OF BENEFICIAL USE

UNDER


Application No. S-85820 Permit No. S-54100

IN THE NAME OF

VICTOR SCHNEIDER, JR

September 24, 2010 & August 23, 2018

SCALE: 1" = 1320'

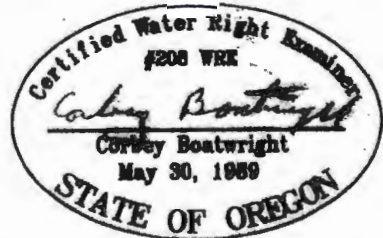

NOTE: This map is not intended to provide legal dimensions or locations of property ownership lines.

RENEWAL DATE: DECEMBER 31, 2021