


THE WEST 1/2, SEC. 1 & E1/2, SEC. 2,
TOWNSHIP 3 S. RANGE 16 E. W.M.
SHERMAN COUNTY, OREGON

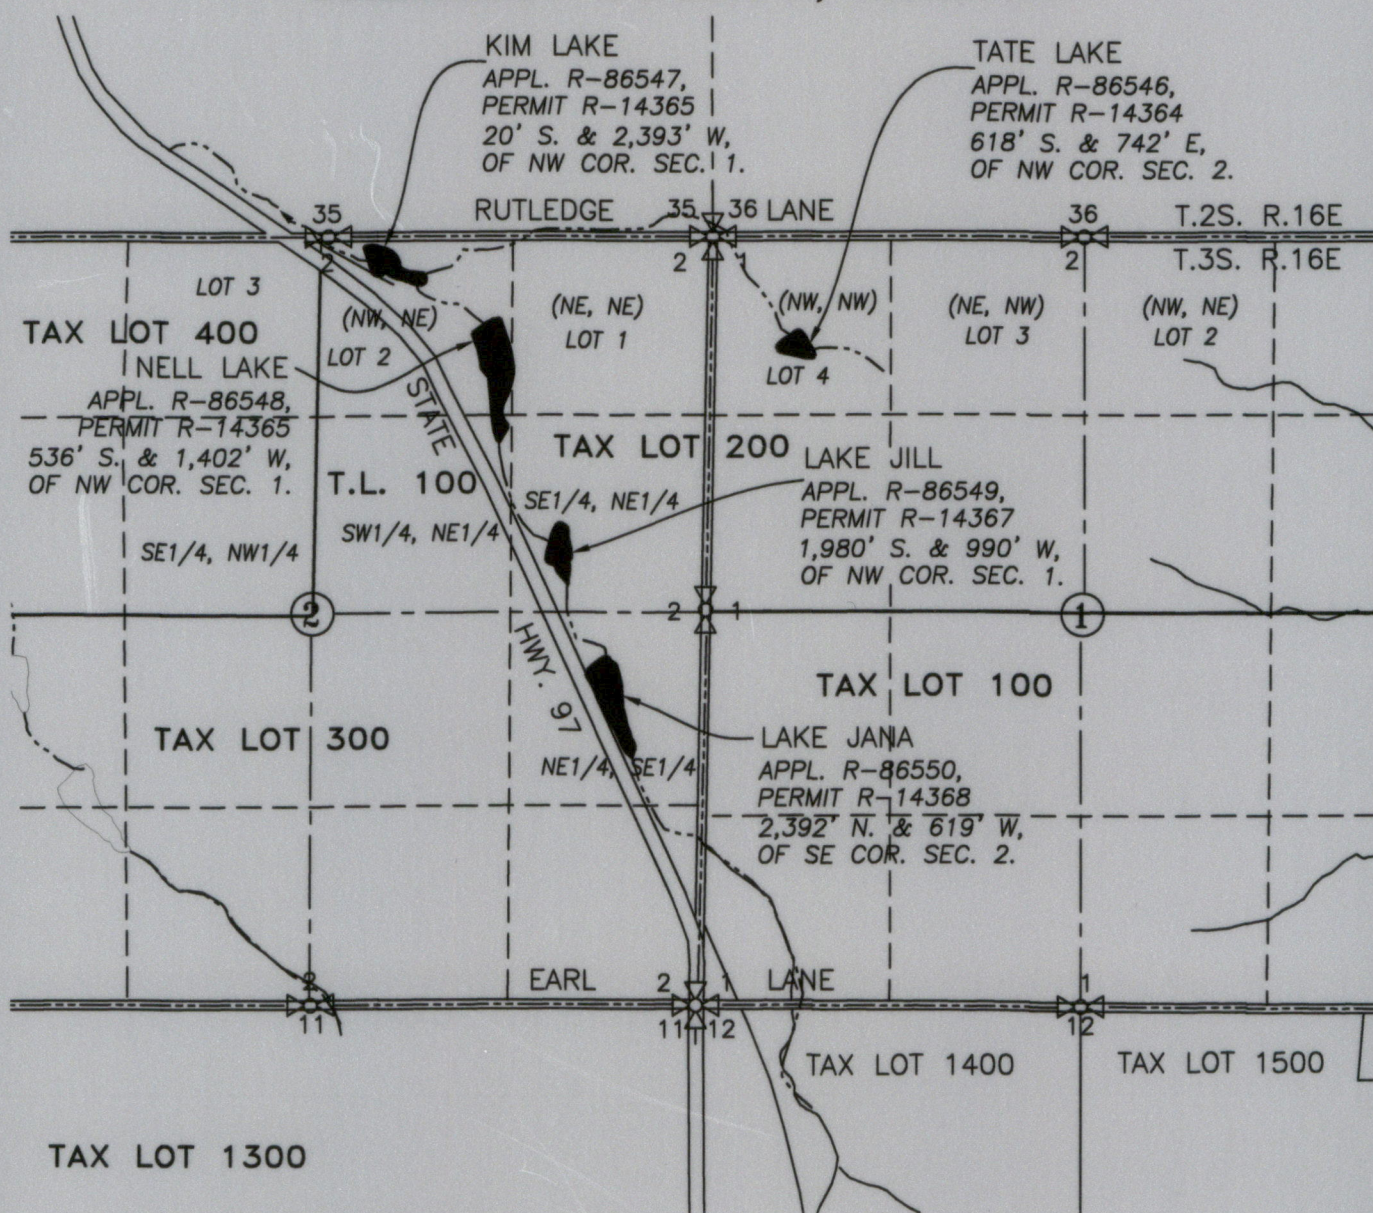


LEGEND :

-  RESERVOIR (LAKE)
-  STREAM WITH DIRECTIONAL FLOW

CLAIM OF BENEFICIAL USE MAP

SCALE: 1" = 1320'

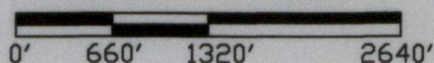

RECEIVED

JUN 14 2022

OWRD



COBU MAP #
2027


APPLICATION No. R-86546, R-86547, R-86548,
R-86549, R-86550

PERMIT No. R-14364, R-14365, R-14366
R-14367, R-14368

IN THE NAME OF:

BUCK HOLLOW RANCH, INC.

DATE: MAY 10, 2022

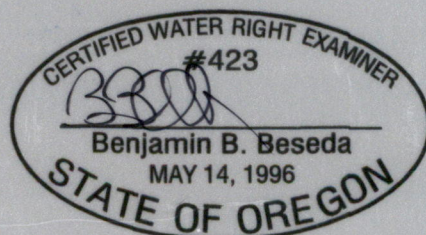

EXPIRES: 12/31/2023

BY: **TENNESON ENGINEERING CORP.**

3775 CRATES WAY
THE DALLES, OREGON. 97058
PH. 541-296-9177
FAX 541-296-6657



NOTE:

"THIS MAP IS NOT INTENDED TO PROVIDE
LEGAL DIMENSIONS OR LOCATIONS OF
PROPERTY OWNERSHIP LINES."

W.O. #12025