


SECTION 2, TWP.3 S. RANGE 16 E. W.M.
SHERMAN COUNTY, OREGON

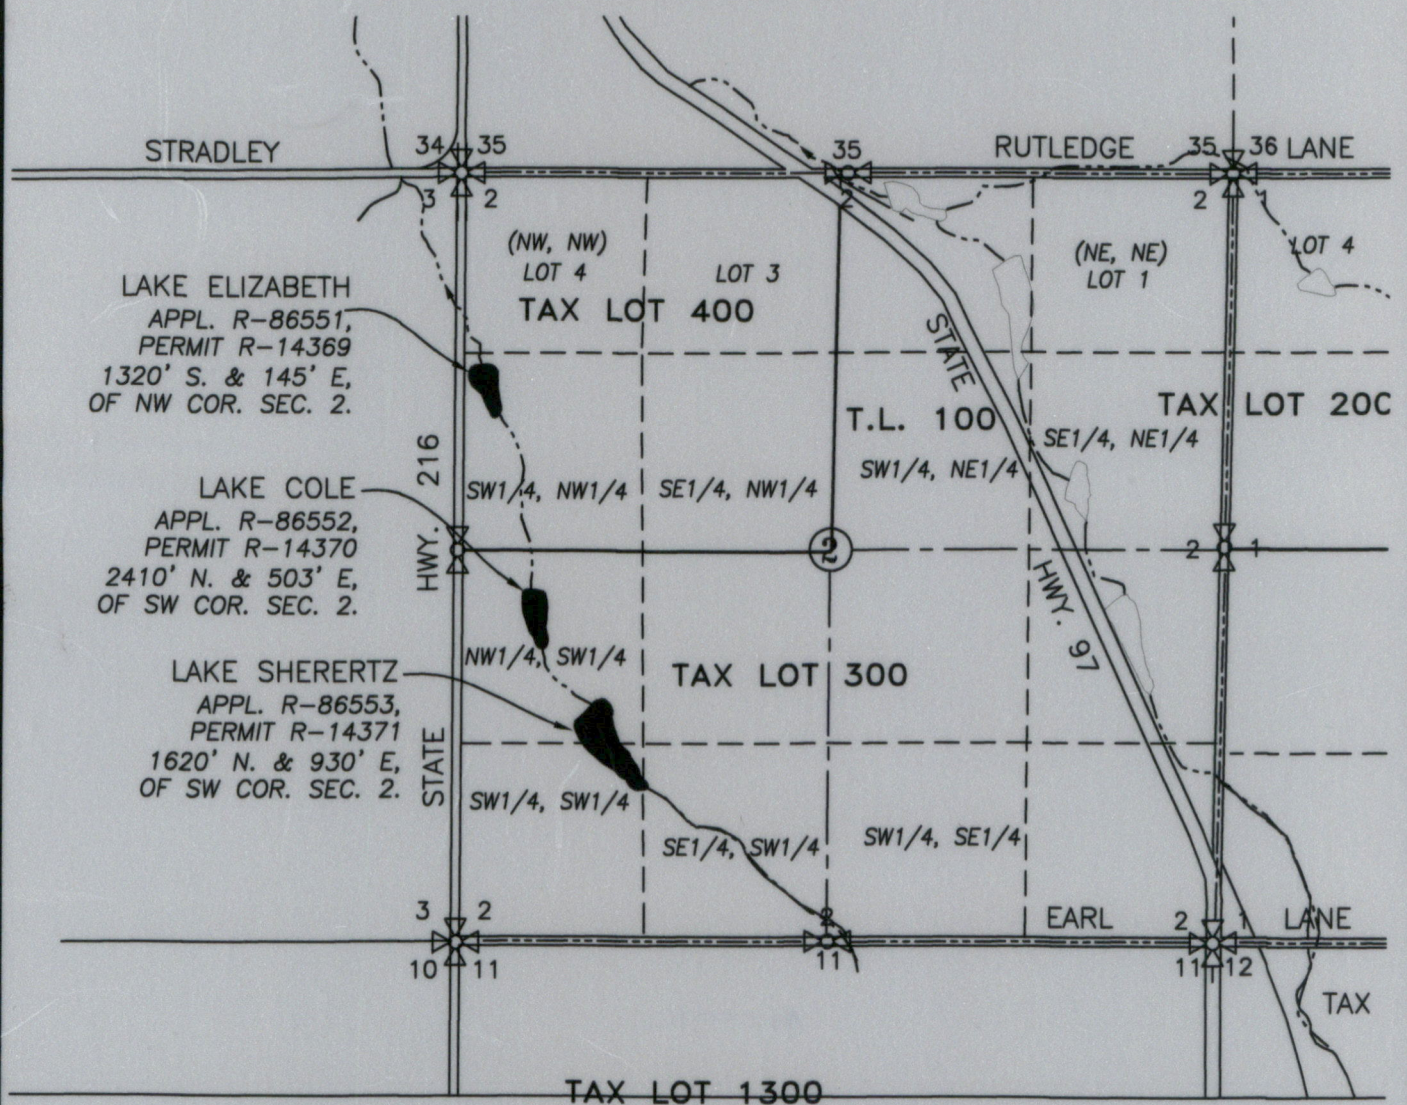

LEGEND :

- RESERVOIR (LAKE)
- STREAM WITH DIRECTIONAL FLOW


RECEIVED

JUN 14 2022

OWRD



CLAIM OF BENEFICIAL USE MAP

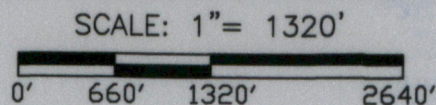

COBU MAP #
2025


APPLICATION No. R-86551, R-86552, R-86553

PERMIT No. R-14369, R-14370, R-14371

IN THE NAME OF:

BUCK HOLLOW RANCH, INC.

DATE: MAY 10, 2022

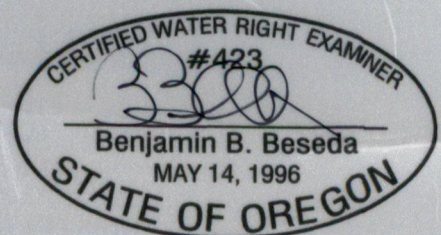

EXPIRES: 12/31/2023

BY: **TENNESON ENGINEERING CORP.**
3775 CRATES WAY
THE DALLES, OREGON. 97058
PH. 541-296-9177
FAX 541-296-6657



NOTE:

"THIS MAP IS NOT INTENDED TO PROVIDE
LEGAL DIMENSIONS OR LOCATIONS OF
PROPERTY OWNERSHIP LINES."

W.O. #12028