


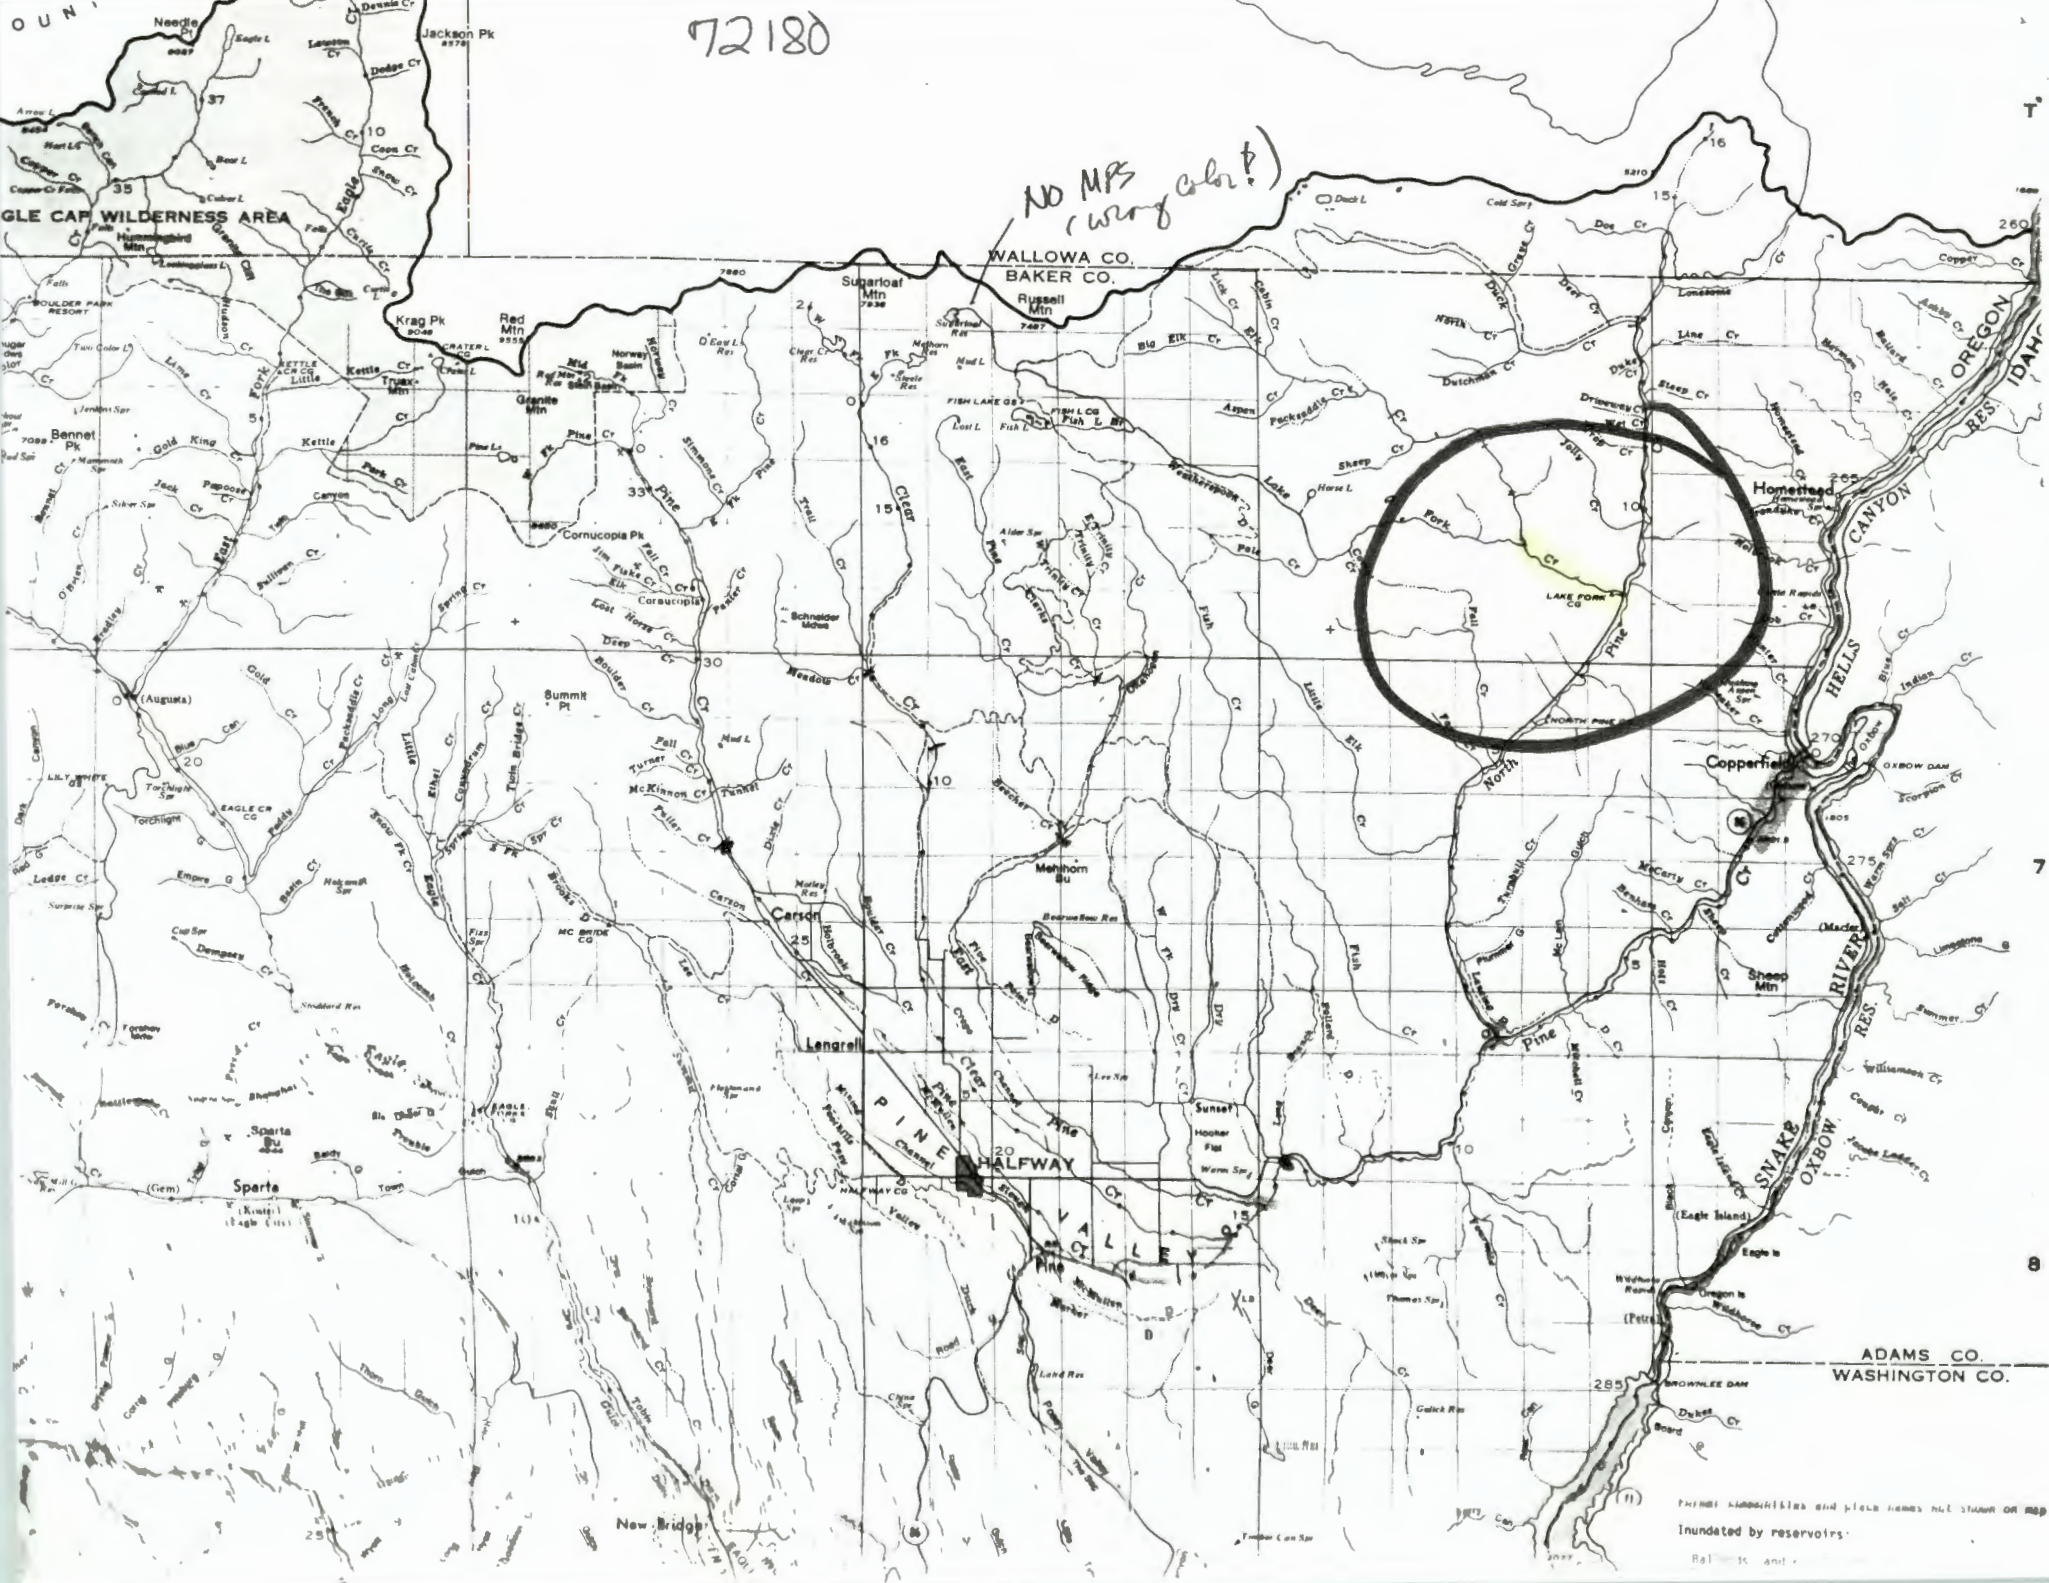

72180

NO MP (wrong color!)

GLE CAP WILDERNESS AREA

WALLOWA CO.
BAKER CO.

ADAMS CO.
WASHINGTON CO.

Printed publications and place names not shown on map
Inundated by reservoirs.
Railroads and