


NOTES:

1. THIS MAP WAS PREPARED FROM FIELD MEASUREMENTS, NAIP 2020 AERIAL PHOTOGRAPHS, KLAMATH COUNTY TAX MAPS, AND OREGON GLO MAPS.
2. THE PURPOSE OF THIS MAP IS TO IDENTIFY THE LOCATION OF THE WATER RIGHT ONLY, AND IS NOT INTENDED TO PROVIDE DIMENSIONS OR LOCATION OF PROPERTY LINES.
3. DATE OF PRIORITY FOR CERTIFICATE 48601 IS NOVEMBER 17, 1976 AND DATE OF PRIORITY FOR CERTIFICATE 67947 IS MARCH 8, 1982.

WELL LOCATION:

WELL 1 (KLAM 56498): 621' NORTH & 1137' WEST FROM THE SOUTHEAST CORNER OF SECTION 8.

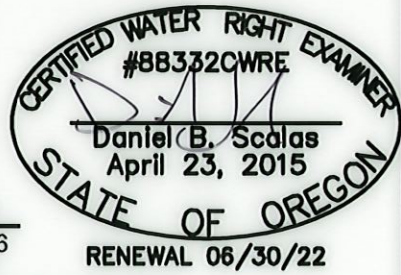

LEGEND

IRRIGATED ACRES (PRIORITY DATE: NOVEMBER 17, 1976) 1/4 1/4 SECTION	SECTION CORNER	SECTION LINE
IRRIGATED ACRES (PRIORITY DATE: MARCH 8, 1982) 1/4 1/4 SECTION	TL 0000 TAX LOT NUMBER	1/4 1/4 LINE
IRRIGATED UNDER TRANSFER T-10471 (PRIORITY DATE: MARCH 8, 1982)	POA (WELL)	TAX LOT LINE
	FLOWMETER	CANAL
	IRRIGATED UNDER TRANSFER T-10471 (PRIORITY DATE: NOVEMBER 17, 1976)	ROAD

RECEIVED
JUN 24 2021
OWRD

AL ADKINS ENGINEERING & SURVEYING
o / 541.884.4666
w / AdkinsEngineering.com

1435 ESPLANADE AVENUE, KLAMATH FALLS, OR 97601

SERVING S. OREGON & N. CALIFORNIA

ENGINEERING • SURVEYING • PLANNING • TESTING

CLAIM OF BENEFICIAL USE AND FINAL PROOF MAP

FOR
GARY OREM
T41S, R10E, SEC. 8, WM
KLAMATH COUNTY, OREGON
TRANSFER T-10471