

COBU MAP # 1262


# RUDD FARMS T-13024 CLAIM OF BENEFICIAL USE

## FOR A TRANSFER OF A POINT OF APPROPRIATION

Situated in the Southwest quarter of Section 12 and the Northwest quarter of Section 13, Township 3 South, Range 38 East of the Willamette Meridian, Union County, Oregon


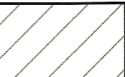
TOWNSHIP 3 SOUTH  
RANGE 38 EAST

1/4  
11/12

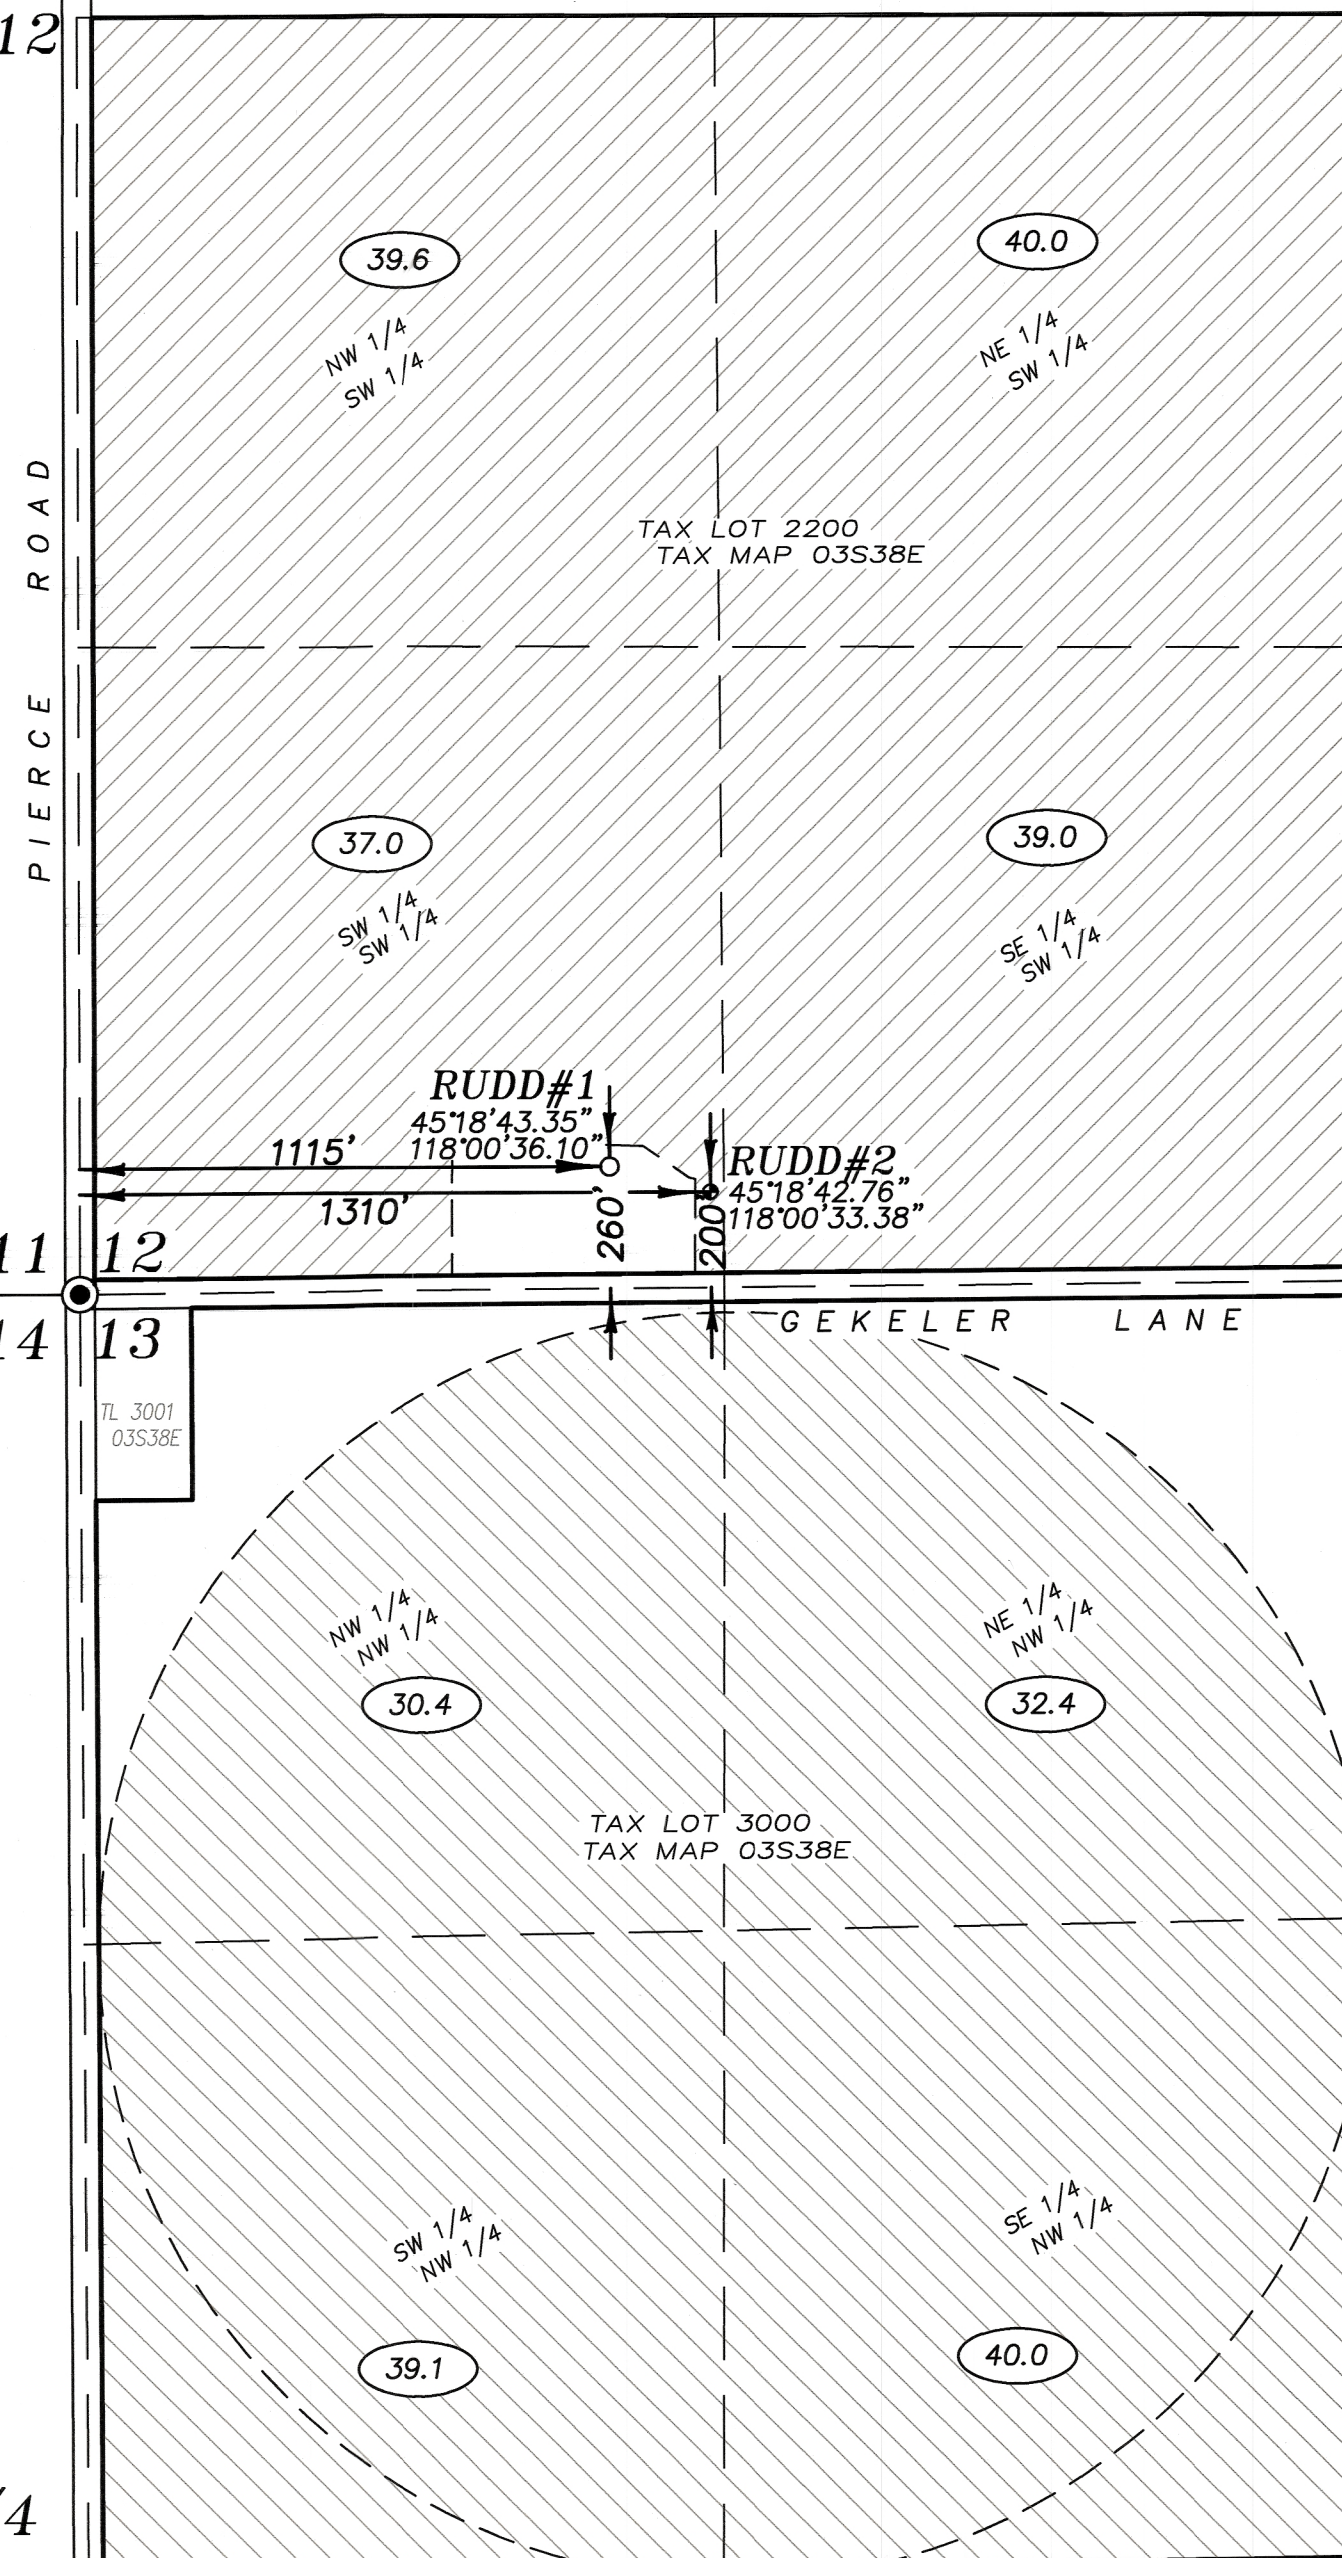

SCALE: 1"=400'

### LEGEND

- RUDD #1 - Old Point of Diversion
- RUDD #2 - New Point of Diversion
-  Land irrigated under C-68271
-  Land irrigated under C-58342



Renews: June 30, 2021

NOTE: the preparation of this map was for the purpose of identifying locations of water rights and is not intended to provide dimensions or location of property ownership lines.

RECEIVED

OCT 23 2020

OWRD

BY  
**BAGETT, GRIFFITH AND BLACKMAN**  
 2006 ADAMS AVE  
 LA GRANDE, OR 97850  
 OCTOBER 8, 2020

1/4  
14/13