

LEGEND

- Point of Diversion (POD)
- Place of Use for T-13269
- ▨ Primary Irrigation (IR), former Cert. 42579
- ▨ Supplemental Irrigation (IS), former Cert. 44240
- ▨ Cert. 43620 (IR)
- ▨ Cert. 94946 (IS)
- ▨ Cert. 94947 (IS)
- ▨ Cert. 94946 (IR)
- ▨ Cert. 94947 (IS)
- Existing Structure
- Railroad
- Government Lot (GL)
- Donation Land Claim (DLC)
- Major Road
- Tax Lot
- Watercourse
- Waterbody

Claim of Beneficial Use Map
Transfer T-13269
A Water Right in the Name of Bailey Nurseries
 Yamhill County
 Township 2 South, Range 4 West (W.M.)

RECEIVED


NOV 10 2021

OWRD

DISCLAIMER
 This map was prepared for the purpose of identifying the location of a water right only and it is not intended to provide legal dimensions or location of property ownership lines.

Date: October 8, 2021
 Data Sources: BLM, ESRI, OWRD, USGS

CERTIFIED WATER RIGHTS EXAMINER STAMP

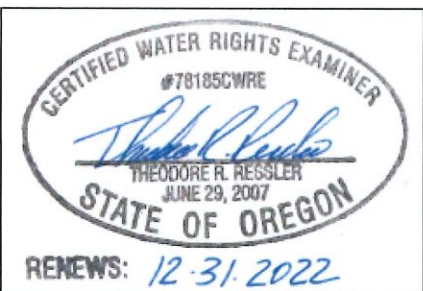

POD LOCATION DESCRIPTION

- POD 1:** Unnamed Stream (former Cert. 42579), located 50' N. and 1,420' W. from SE corner DLC 55.
- POD 2:** Salt Creek (former Cert. 42579), located 220' N. and 1,380' W. from SE corner DLC 55.
- POD 3:** Salt Creek (former Cert. 42579), located 1,960' S. and 2,260' W. from SE corner of DLC 55.
- POD 4:** Fidel Reservoir (former Cert. 42579), located 420' N. and 1,480' W. from the SE corner of DLC 55.
- POD 5:** North Yamhill River (former Cert. 44240), located 2,180' S. and 4,280' W. from SE Corner DLC 55.

