

**LEGEND**

- Point of Diversion (POD)
- Place of Use for T-13269
- ▨ Primary Irrigation (IR), former Cert. 42579
- ▨ Supplemental Irrigation (IS), former Cert. 44240
- ▨ Cert. 43620 (IR)
- ▨ Cert. 94946 (IS)
- ▨ Cert. 94947 (IS)
- ▨ Cert. 94946 (IR)
- ▨ Cert. 94947 (IS)
- Existing Structure
- Railroad
- Government Lot (GL)
- ▨ Donation Land Claim (DLC)
- Major Road
- Tax Lot
- Watercourse
- Waterbody

**Claim of Beneficial Use Map**

**Transfer T-13269**

**A Water Right in the Name of Bailey Nurseries**

Yamhill County

Township 2 South, Range 4 West (W.M.)

RECEIVED

NOV 10 2021


OWRD

**DISCLAIMER**

This map was prepared for the purpose of identifying the location of a water right only and it is not intended to provide legal dimensions or location of property ownership lines.

Date: October 8, 2021  
Data Sources: BLM, ESRI, OWRD, USGS

**CERTIFIED WATER RIGHTS EXAMINER STAMP**

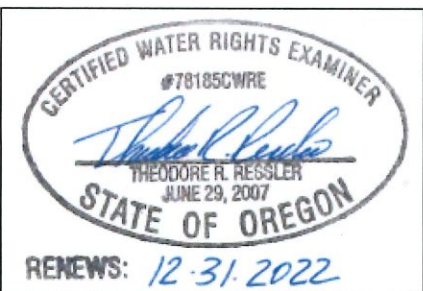

**POD LOCATION DESCRIPTION**

- POD 1:** Unnamed Stream (former Cert. 42579), located 50' N. and 1,420' W. from SE corner DLC 55.
- POD 2:** Salt Creek (former Cert. 42579), located 220' N. and 1,380' W. from SE corner DLC 55.
- POD 3:** Salt Creek (former Cert. 42579), located 1,960' S. and 2,260' W. from SE corner of DLC 55.
- POD 4:** Fidel Reservoir (former Cert. 42579), located 420' N. and 1,480' W. from the SE corner of DLC 55.
- POD 5:** North Yamhill River (former Cert. 44240), located 2,180' S. and 4,280' W. from SE Corner DLC 55.

